

GEODETIC SURVEY OF M.S.W.

CENTRAL MAPPING AUTHORITY


GEODETIC STATION RECONNAISSANCE and MAINTENANCE REPORT

STATION: LOONEY No.: 2294

MAP SHEET SCALE 1:250 000 NAME OF MINE

INSPECTED BY: C.A.C HANUJA DATE: 26/5/18

AUTHORITY: C.M.A. FIELD BOOK:

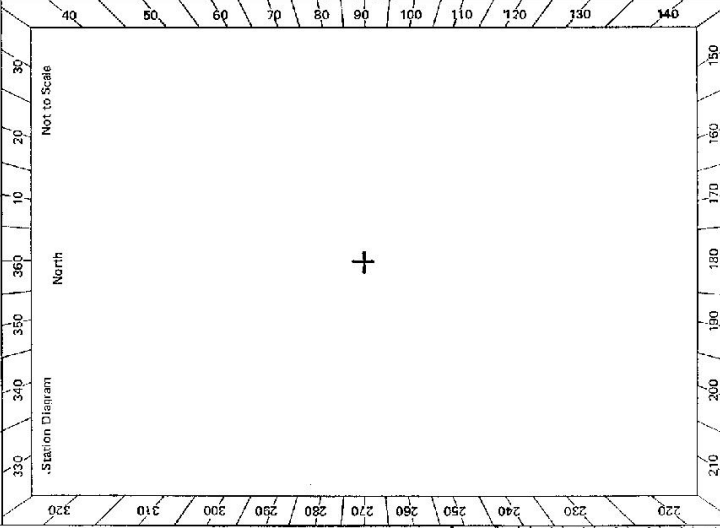

- Description:
- Note: Cross out word or words which do not apply
- Cleared by lanes bearing..... from Trig, Mast
 - Mast & Vanes have been painted white & black respectively.
 - The station/pillar was unpiled/not unpiled/constructed on.....19....., dimensions now being:
 - Description of mark.....should be explicit, e.g., S/Steel Pillar Plate, Steel plug, Brass plug, Bolt, G.I. Pipe
 - Height of mark.....m. ^{above}/_{below} rock/concrete; Mark is.....m. ^{above}/_{below} G.L.
 - Height of Top Vanes to Top Mark/Pillar platem. Diameter of Vanes (vertical).....m.
 - Height of Cairn.....m. Diameter of Cairn.....m. Name Plate found/not found/placed.
 - Length of Mast.....m. (approximate if not unpiled)
 - A.....set in conc/rock has been placed/found, bearing.....°M from Mast/Plug/Pillar
 - A.....set in conc/rock has been placed/found, bearing.....°M from Mast/Plug/Pillar
 - A.....set in conc/rock has been placed/found, bearing.....°M from Mast/Plug/Pillar
 - A.....set in conc/rock has been placed/found, bearing.....°M from Mast/Plug/Pillar
 - Action required:.....

STANDPOINT:

Mark	Direction	Horiz. Distance	Height Difference	Mark	Direction	Horiz. Distance	Height Difference
			above standpt.				above standpt.
			below standpt.				below standpt.
			above standpt.				above standpt.
			below standpt.				below standpt.
			above standpt.				above standpt.
			below standpt.				below standpt.
			above standpt.				above standpt.
			below standpt.				below standpt.


Prepared by: C. HANUJA

Checked: Noted on U.T.M. Card

Checked

SI 2733-2 D. West, Government Printer

STATION **LODNEY** **TS 2894**
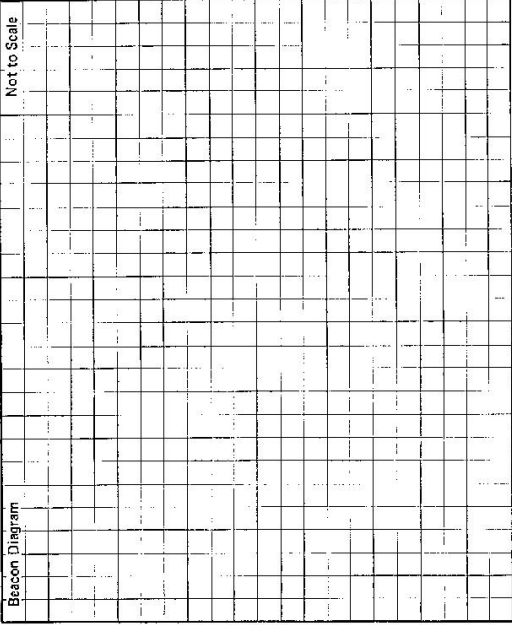
<p>Owner's Name:</p> <p>Address:</p> <p>Phone:</p> <p>Current Occupant:</p> <p>Address:</p> <p>Phone:</p> <p>ACCESS</p> <p>Access Report of <u>26/9/1978</u> was found suitable/unavailable.</p> <p>Trig can be seen from road On highest point of hill 0.7 Km walk up slight rise Carrn Zn. Mast & Vane. 2.2m Light Clearing required for SAC's vision</p> <p>Access</p> <p>0.0 At Tuillamore towards Trundle 7.7 Gabondery Siding 13.5 RH turn at "F field 19 km" S/Post 18.7 RH turn and follow track 21.0 Stop beside fence & walk to trig</p> <p>All measurements are approximate</p>	<p>Not to Scale</p>  <p>This section to be completed by officer constructing pillar.</p> <p>Original station mark found/not found.</p> <p>Description of mark:</p> <p>Original beacon found/not found.</p> <p>Description of beacon:</p> <p>Height Top of Vane to Top Markm. above below Height of markm. rock/cont.m. above G.L. below below Diameter of Vanem. Height of Cairnm.</p> <p>Original Beacon has/has not been destroyed by me.</p>
<p>Date</p>	
<p>Record of Station</p>	