

MSN-

LAND INFORMATION CENTRE

GEODETIC SURVEY OF N.S.W. *Baital* 1701

GEODETIC STATION RECONNAISSANCE and MAINTENANCE REPORT

STATION: **MACPHERSON** No.: **2925**

Description:

Cleared by lanes bearing **360°** Note: *Cross out word or words which do not apply*

Mast & Vanes ~~have been pointed white & black respectively.~~ **in fair condition**

The station/pillar was unpilled/not unpilled/constructed on **19** dimensions now being:

Description of mark ~~should be explicit, e.g., S/Steel Pillar Plate, Steel plug, Brass plug, Bolt, G.I. Pipe~~

Height of mark ~~above rock/concrete; Mark is~~ ^{above} ~~below~~ **rock/concrete** m. ^{above} ~~below~~ **G.L.** m.

Height of Top Vanes to Top Mark/Pillar plate ~~m. Diameter of Vanes (vertical)~~ **m.**

Height of Cairn ~~m. Diameter of Cairn~~ **m.** Name Plate found/not found/placed.

Length of Mast ~~m. (approximate if not unpilled)~~

A **RM 1** ¹ ~~set in conc/rock has been placed/found, bearing~~ **270°** M from Mast/Plug/Pillar

A **RM 2** ¹ ~~set in conc/rock has been placed/found, bearing~~ **151°** M from Mast/Plug/Pillar

A **SSM** ~~set in conc/rock has been placed/found, bearing~~ **111°** M from Mast/Plug/Pillar

A **RM 4** ⁴ ~~set in conc/rock has been placed/found, bearing~~ **55°** M from Mast/Plug/Pillar


Action required:

STANDPOINT:				STANDPOINT:			
Mark	Direction	Horiz. Distance	Height Difference	Mark	Direction	Horiz. Distance	Height Difference
			above standpt. below				above standpt. below
			above standpt. below				above standpt. below
Prepared by: *gg*

Checked: *gg*

Noted on U.T.M. Card

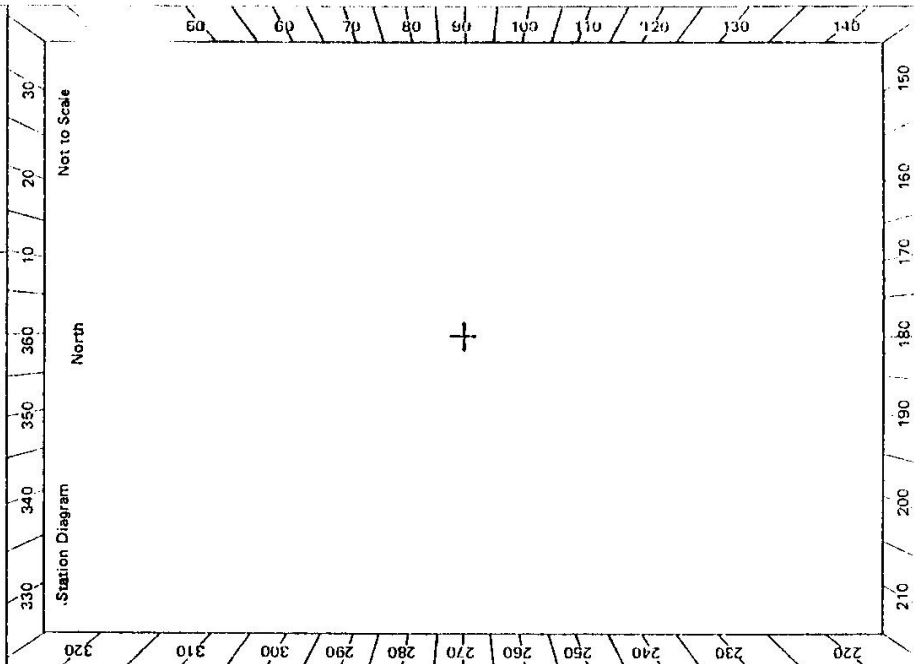

ST-2735-2 D. West, Government Printer

STATION MACPHERSON TS 2925	
Owner's Name: G & K DAVIES Address: "MARRA" VIA TILPA Phone: 088 919491 VHF 24	Current Occupant: Address: Phone: MARCH 1995 4WD ACCESS
Access Report of 49 was found suitable for construction	
Beacon Diagram Not to Scale	<p>From TILPA take road down SOUTH along western side of river for about 42km cross a grid at entrance to "MARRA" is on your left — call in.</p> <p>The road to your right heads towards Δ but is impassable after any rain. Alternative is to keep following main road south for 5.1 km and turn R just before a grid — follow main track.</p> <p>Either way (Direct 17km / Alternative 22.1) then at 0.0 turn R onto inland WILCANNIA / TILPA road.</p> <p>2.5 d 3.7 Grids</p> <p>5.1 Turn hard R onto GAS PIPELINE track</p> <p>5.9 Gate — no fence — turn L d generally head towards 80°M to longest spur coming down from hill. Keep below mulge for as long as possible. With normal tyres a path through the mulge will have to be cleared.</p> <p>10.0 At top of ridge turn L</p> <p>11.4 MACPHERSON Δ *** From 5.9 is littered with sharp mulge ***</p>
This section to be completed by officer constructing pillar. Original station mark found/not found.	
Description of mark:	
Original beacon found/not found.	
Description of beacon:	
Height Top of Vanes to Top Markm.	
Height of markm. above G.L. below rock/concm. below	
Diameter of Vanesm. Height of Cairnm.	
Original Beacon has/has not been destroyed by me.	