

CENTRAL MAPPING AUTHORITY
Department of Lands

Trigonometrical Survey of N.S.W.

RECONNAISSANCE and MAINTENANCE REPORT

This Trig. Station has been:-


Note: Cross out word or words which do not apply

1. Completely cleared to permit 360° vision to surrounding Trigs.
 2. Cleared by lances bearing 76° 52' 30", 85° 10' 30", 333° 29' 30" from Trig. Mast
 3. Trig. Mast & Vanes have been painted white & black respectively. ✓
 4. The Trig. was unpiled/not unpiled, dimensions now being: CONCRETE OBS. V. L.P. should be explicit, e.g. Steel plug, Brass plug, Bolt, G.I. Pipe
- Description of mark CONCRETE OBS. V. L.P. 1.20 m above rock/concrete G.L.
- Height of mark 1.20 m above rock/concrete G.L.
- Height of Top Vanes to Top Mark 1.471 m. ✓ Diameter of Vanes (vertical) 0.756 m.
- Height of Cairn.....m. Diameter of Cairn.....m.

- Length of Mast.....m. (approximate if not unpiled)
5. G.I.P. set in conc/rock has been placed 0.733 m. bearing 52 °M from Trig. Mast ALL
 6. A.....set in conc/soil has been placed.....m. bearing.....°M from Trig. Mast
 7. A.....set in conc/soil has been placed.....m. bearing.....°M from Trig. Mast
 8. A.....set in conc/rock has been placed.....m. bearing.....°M from Trig. Mast
 9. Connection.....to.....m. bearing.....°M
 10. Connection.....to.....m. bearing.....°M
 11. Connection.....to.....m. bearing.....°M
 12. Connection.....to.....m. bearing.....°M
 13. Diff. Ht. G.I.P. is 1.66 m. below CONCRETE
 14. Diff. Ht. is .. m. ^{above} _{below} ..
 15. Diff. Ht. is .. m. ^{above} _{below} ..
 16. Diff. Ht. is .. m. ^{above} _{below} ..
- Prepared by: PHS 303 MAH 1977 Checked: MAH
- Noted on U.T.M. Card

STATION KACQUALIE KILLIE C.S. 2926

Co: LANDS PII: SHAW
Map Sheet: 61 MAJBY No: 8730
Inspected by: F KMS Date: 2/5/77
Authority: EMA Field Book: 15501

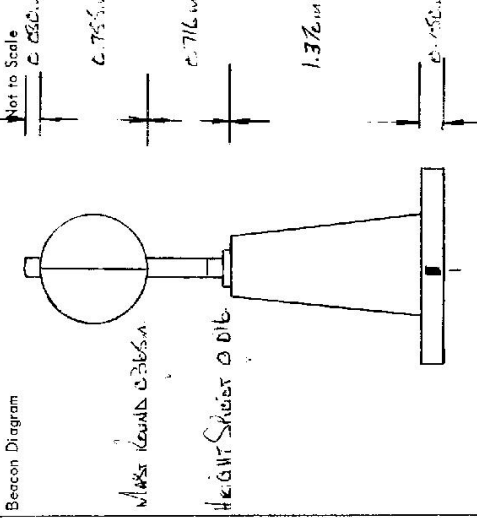

Date: 22/4/77 Record of Station
31577 CONCRETE PILLAR PLACED
NAME PLATE PLACED
CONCRETE OBS. PILLAR PLACED
BRASS TAG PIN

Checked

CENTRAL MAPPING AUTHORITY

GEODETIC SURVEY OF M.S.W.

GEODETIC STATION RECONNAISSANCE and MAINTENANCE REPORT

Description:

Note: Cross out word or words which do not apply

- Cleared by lanes bearing South of 299 + 16 bearing 73 127 - 146 178 - 198 from Trig. Mast
- Mast & Vanes have been painted white & black respectively. ✓
- The station/pillar was unpiled/not unpiled/constructed on 19 dimensions now being: Description of mark SP PILLAR PLATE should be explicit, e.g. S/Steel Pillar Plate, Steel plug, Brass plug, Bolt, G.I. Pipe
- Height of mark 1.375 m. ^{above} 1.75 m. ^{below} G.L. Diameter of Vanes (vertical) 0.250 m.
- Height of Top Vanes to Top Mark/Pillar plate 1.45 m. Diameter of Cairn m. Name Plate found/not found/placed.
- Height of Cairn m. Diameter of Cairn m. Name Plate found/not found/placed.
- Length of Mast m. (approximate if not unpiled)
- A set in conc/rock has been placed/found, bearing ° M from Mast/Plug/Pillar
- A set in conc/rock has been placed/found, bearing ° M from Mast/Plug/Pillar
- A set in conc/rock has been placed/found, bearing ° M from Mast/Plug/Pillar
- A set in conc/rock has been placed/found, bearing ° M from Mast/Plug/Pillar

8. Action required:

STANDPOINT:		CONC PILLAR ✓				STANDPOINT:			
Mark	Direction	Horiz. Distance	Height Difference	Mark	Direction	Horiz. Distance	Height Difference		
HOPKINS (P)	0 00 00 ✓		above standpt.				above standpt.		
ERROL (P)	87 59 00		above standpt.				above standpt.		
MORLEDA (P)	144 09 40 ✓		below				below		
THREE BATHURS (P)	147 03 00 ✓		above standpt.				above standpt.		
ARKELL (P)	201 32 00 ✓		below				below		
WILLARD (P)	208 02 40 ✓		above standpt.				above standpt.		
SUMMERS (P)	255 53 20 ✓		below				below		

Prepared by: S Ford

Checked: 27 12 12

Noted on U.T.M. Card

Checked

STATION: MACQUARIE (P) No.: 2926

MAP SHEET BATHURS

SCALE 1:250 000

INSPECTED BY: G FORD DATE: 6 - 9 - 83

AUTHORITY: C.M.A. FIELD BOOK: 1939

Station Diagram

North

Nat. to Scale

Checked

G

<p>STATION MACQUARIE (P) / TS 2926</p> <p>Owner's Name: TR 37546 Address: FORESTRY COMMISSION Phone: OXFORD 6.2.5.2.2</p> <p>Current Occupant: Address: Phone:</p> <p style="text-align: center;">ACCESS</p> <p>Access Report of 6.9.1983 was found suitable/unsuitable.</p>	<p>Not to Scale</p> <p style="text-align: center;">This section to be completed by officer constructing pillar.</p> <p>Original station mark found/not found.</p> <p>Description of mark:</p> <p>Original beacon found/not found.</p> <p>Description of beacon:</p> <p>Height: Top of Vanes to Top Markm.</p> <p>Height of markm. above G.L. below</p> <p>Diameter of Vanesm. Height of Cairnm.</p> <p>Original Beacon has/has not been destroyed by me.</p>
<p>Date</p>	
<p>Record of Station</p>	

Sr-2733-2-D, West, Government Printer

GEODETTIC SURVEY OF A.S.W.

CENTRAL MAPPING AUTHORITY

GEODETTIC STATION RECONNAISSANCE and MAINTENANCE REPORT

Description: *Note: Cross out word or words which do not apply*

1. Cleared by lanes bearing..... from Trig, Mast
2. Mast & Vanes have been painted white & black respectively.
3. The station/pillar was unpiled/not unpiled/constructed on..... 19....., dimensions now being:
Description of mark..... should be explicit, e.g., S/Steel Pillar Plate, Steel plug, Brass plug, Bolt, G.I. Pipe
Height of mark..... m. ^{above} _{below} rock/concrete; Mark is..... m. ^{above} _{below} G.L.
Height of Top Vanes to Top Mark/Pillar plate ~~..... m.~~ ^{0.1}..... m. Diameter of Vanes (vertical)..... m.
Height of Cairn..... m. ^{NAME} Diameter of Cairn..... m. Name Plate found/not found/placed.
Length of Mast ~~..... m.~~ ^{Mast} (approximate if not unpiled)
4. A..... ^{NEW} set in conc/rock has been placed/found, bearing..... °M from Mast/Plug/Pillar
5. A..... set in conc/rock has been placed/found, bearing..... °M from Mast/Plug/Pillar
6. A..... set in conc/rock has been placed/found, bearing..... °M from Mast/Plug/Pillar
7. A..... set in conc/rock has been placed/found, bearing..... °M from Mast/Plug/Pillar
8. Action required:.....

STANDPOINT:

Mark	Direction	Horiz. Distance	Height Difference	Mark	Direction	Horiz. Distance	Height Difference
			above standpt				below standpt
			below standpt				above standpt
			above standpt				below standpt
			below standpt				above standpt
Prepared by: P. Perms 24/10/88

Checked: A

Noted on U.T.M. Card

Checked: A

STATION: *MACQUARIE (A)* No.: *2926*
 MAP SHEETS SCALE 1:250 000 *BATHURST* SCALE 1:100 000
 INSPECTED BY: *P. Perms* DATE: *7/10/88*
 AUTHORITY: *CMA* FIELD BOOK: *1984*

GS 24

<p>2733 - 2 D. West, Government Printer</p> <p>Beacon Diagram</p>		<p>STATION <u>MACQUARIE CA TS 2926</u></p> <p>Owner's Name:</p> <p>Address:</p> <p>Phone:</p> <p>Current Occupant:</p> <p>Address:</p> <p>Phone:</p> <p>Access Report of <u>7/10/88</u> was found suitable/unsuitable. <u>ACCESS</u></p>
<p>This section to be completed by officer constructing pillar.</p> <p>Original station mark found/not found.</p> <p>Description of mark:</p> <p>Original beacon found/not found.</p> <p>Description of beacon:</p> <p>Height Top of Vanes to Top Markm.</p> <p>Height of markm. above G.L. below rock/conc.m. below</p> <p>Diameter of Vanesm. Height of Cairnm.</p> <p>Original Beacon has/has not been destroyed by me.</p>		<p>Date</p> <p>Record of Station</p>

TS 2926

GEODETIC SURVEY OF A.S.W.

LAND INFORMATION CENTRE

GEODETIC STATION RECONNAISSANCE and MAINTENANCE REPORT

Description: *Note: Cross out word or words which do not apply*

1. Cleared by lanes bearing..... from Trig. Mast

2. Mast & Vanes have been painted white & black respectively.

3. The station/pillar was unpiled/not unpiled/constructed on..... 19....., dimensions now being:

Description of mark..... should be explicit, e.g., S/Steel Pillar Plate, Steel plug, Brass plug, Bolt, G.I. Pipe

Height of mark.....m. ^{above} rock/concrete; Mark is.....m. ^{above} G.L. _{below}

Height of Top Vanes to Top Mark/Pillar plate.....m. Diameter of Vanes (vertical).....m.

Height of Cairn.....m. Diameter of Cairn.....m. Name Plate found/not found/placed.

Length of Mast.....m. (approximate if not unpiled)

4. A..... set in conc/rock has been placed/found, bearing.....° M from Mast/Plug/Pillar

5. A..... set in conc/rock has been placed/found, bearing.....° M from Mast/Plug/Pillar

6. A..... set in conc/rock has been placed/found, bearing.....° M from Mast/Plug/Pillar

7. A..... set in conc/rock has been placed/found, bearing.....° M from Mast/Plug/Pillar

8. Action required:.....

STANDPOINT:				STANDPOINT:			
Mark	Direction	Horiz. Distance	Height Difference	Mark	Direction	Horiz. Distance	Height Difference
			above standpt.				above standpt.
			below				below
			above standpt.				above standpt.
			below				below
Prepared by: *[Signature]*

Checked: *[Signature]*

Noted on U.T.M. Card

S: 2733-1

STATION: *MAGUIRDIE BR* MAP SHEET SCALE 1:250 000 INSPECTED BY: *L HITCHINS* DATE: *22.4.91* FIELD BOOK: *---*

AUTHORITY: *L.I.C.*

Station Diagram

Not to Scale

North

