

CENTRAL MAPPING AUTHORITY

GEODETIC SURVEY OF N.S.W.

GEODETIC STATION RECONNAISSANCE and MAINTENANCE REPORT


- Description:
1. Cleared by lanes bearing..... Note: Cross out word or words which do not apply
 2. Mast & Vanes have been painted white & black respectively. from Trig, Mast
 3. The station/pillar was unpiled/not unpiled/constructed on.....19....., dimensions now being: Description of mark.....should be explicit, e.g., S/Steel Pillar Plate, Steel plug, Brass plug, Bolt, G.I. Pipe
- Height of mark.....m. ^{above} rock/concrete; Mark is.....m. ^{above} G.L.
- Height of Top Vanes to Top Mark/Pillar platem. Diameter of Vanes (vertical).....m.
- Height of Cairn.....m. Diameter of Cairn.....m. Name Plate found/not found/placed.
- Length of Mast.....m. (approximate if not unpiled)
4. A.....set in conc/rock has been placed/found, bearing.....° M from Mast/Plug/Pillar
 5. A.....set in conc/rock has been placed/found, bearing.....° M from Mast/Plug/Pillar
 6. A.....set in conc/rock has been placed/found, bearing.....° M from Mast/Plug/Pillar
 7. A.....set in conc/rock has been placed/found, bearing.....° M from Mast/Plug/Pillar

8. Action required: **NEW FLANGE REQUIRED ON BASE OF MAST**
 NAME PLATE REPOS: MADDEN NEW T.S.

STANDPOINT: **S/STEEL PILLAR PLATE**

Mark	Direction	Horiz. Distance	Height Difference	Mark	Direction	Horiz. Distance	Height Difference
LETTER BOX G.S.(P)	0 00 00		above standpt.				above standpt.
SOUTHERD G.S.(P)	12 39 20		above standpt.				above standpt.
S/STEEL PILL	19 44 50	4.134	1.360 below				above standpt.
9029 - 0095 G.I. PIPE	113 40 58	29.676	1.997 below				above standpt.
COPPER NAIL	307 14 34	3.728	1.598 below				above standpt.
BULLI G.S.(P)	307 16 35		above standpt.				above standpt.

Prepared by: *[Signature]* 18/3/81 Checked: *[Signature]* Noted on U.T.M. Card

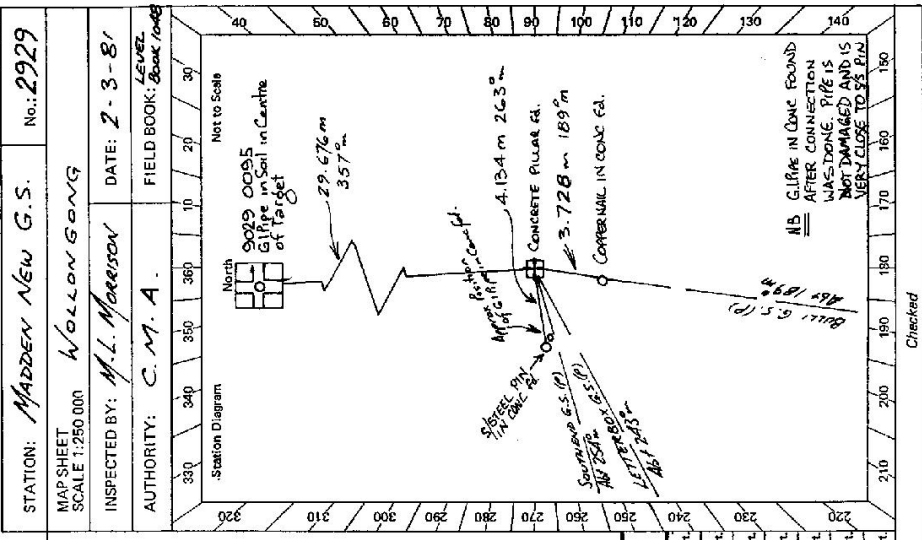

Station Diagram

North

Not to Scale

Checked

STATION MADDEN NEW G.S. 15 2929	Owner's Name: Address: Phone: Current Occupant: Address: Phone: Access Report of...../10..... was found suitable/unsuitable. * NOTE LOCKED GATE. ACCESS <table style="width: 100%; border-collapse: collapse;"> <tr> <td style="width: 10%; text-align: center;"><u>Km</u></td> <td style="width: 10%; text-align: center;"><u>DIRECTION</u></td> </tr> <tr> <td style="text-align: center;">0.00</td> <td>ON PRINCES HWY SOUTH OF HELENSBURGH AT DARKES FOREST TURN OFF. HEAD SOUTH OVER BRIDGE TOWARDS WOLLONGONG</td> </tr> <tr> <td style="text-align: center;">2.63</td> <td>TURN LEFT ONTO SINGLE LANE SEALED ROAD</td> </tr> <tr> <td style="text-align: center;">2.87</td> <td>PASS ROAD ON LEFT TO REPEATER STN.</td> </tr> <tr> <td style="text-align: center;">* 3.03</td> <td>TURN LEFT THROUGH LOCKED GATE (CMA LOCK)</td> </tr> <tr> <td style="text-align: center;">3.40</td> <td>FOLLOW ROAD TO LEFT.</td> </tr> <tr> <td style="text-align: center;">3.47</td> <td>TURN LEFT ONTO TRACK TOWARDS REPEATER STN.</td> </tr> <tr> <td style="text-align: center;">3.65</td> <td>MADDEN NEW G.S.</td> </tr> </table>	<u>Km</u>	<u>DIRECTION</u>	0.00	ON PRINCES HWY SOUTH OF HELENSBURGH AT DARKES FOREST TURN OFF. HEAD SOUTH OVER BRIDGE TOWARDS WOLLONGONG	2.63	TURN LEFT ONTO SINGLE LANE SEALED ROAD	2.87	PASS ROAD ON LEFT TO REPEATER STN.	* 3.03	TURN LEFT THROUGH LOCKED GATE (CMA LOCK)	3.40	FOLLOW ROAD TO LEFT.	3.47	TURN LEFT ONTO TRACK TOWARDS REPEATER STN.	3.65	MADDEN NEW G.S.
<u>Km</u>	<u>DIRECTION</u>																
0.00	ON PRINCES HWY SOUTH OF HELENSBURGH AT DARKES FOREST TURN OFF. HEAD SOUTH OVER BRIDGE TOWARDS WOLLONGONG																
2.63	TURN LEFT ONTO SINGLE LANE SEALED ROAD																
2.87	PASS ROAD ON LEFT TO REPEATER STN.																
* 3.03	TURN LEFT THROUGH LOCKED GATE (CMA LOCK)																
3.40	FOLLOW ROAD TO LEFT.																
3.47	TURN LEFT ONTO TRACK TOWARDS REPEATER STN.																
3.65	MADDEN NEW G.S.																
Beacon Diagram 	This section to be completed by officer constructing pillar. Original station mark found/not found. Description of mark: Original beacon found/not found. Description of beacon: Height Top of Vanes to Top Mark.....m. Height of mark.....m. above G.L. below Diameter of Vanes.....m. Height of Cairn.....m. Original Beacon has/has not been destroyed by me.																
	Date Record of Station																

Beacon Diagram		Not to Scale
<p>This section to be completed by officer constructing pillar.</p> <p>Original station mark found/not found:</p> <p>Description of mark:</p> <p>Original beacon found/not found:</p> <p>Description of beacon:</p> <p>Height Top of Vanes to Top Mark:m.</p> <p>Height of mark:m. above rock/conc.m. above G.L. below below</p> <p>Diameter of Vanes:m. Height of Cairn:m.</p> <p>Original Beacon has/has not been destroyed by me.</p>		
<p>STATION MADDEN NEW (P) 2929</p> <p>Owner's Name:</p> <p>Address:</p> <p>Phone:</p> <p>Access Report of:/19.....was found suitable/unsuitable.</p> <p style="text-align: center;"><u>July 2000</u></p> <p>2929 Madden New</p> <p>0.00 Bulli Road House take road 60 (princes HWY) North towards Helensburgh 1.0 Bulli pass scenic reserve (Panorama House Restaurant) 2.6 Pass Subline Pt road on right 6.7 Turn right sign The Forest Walk 6.9 Track to left to towers and Madden New Pillar (pillar on western side of towers)</p> <p>Current Occupant:</p> <p>Address:</p> <p>Phone:</p> <p style="text-align: center;">ACCESS</p>		
Date		
<p>INSPECTED BY: G FORD</p> <p style="text-align: center;"><i>ACCESS ONLY</i></p>		<p>DATE: 11-7-00</p>
<p>Record of Station</p>		