






81 2735-2 D. West, Government Printer

STATION MALARA C.S. TS 2942

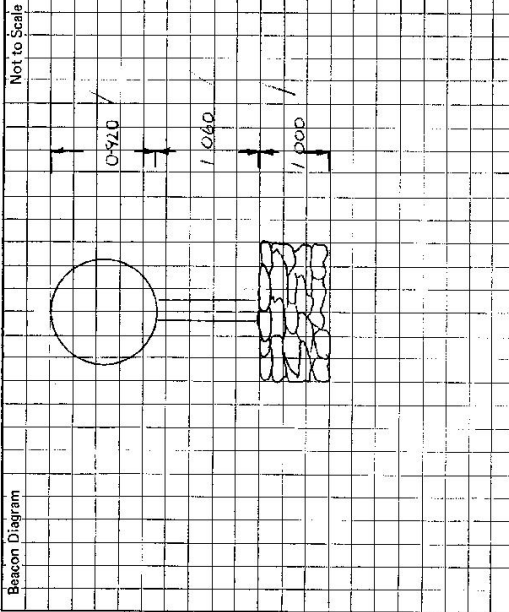

Owner's Name: MR. D.K. KELLY  
 Address: 78 RETRIE STREET  
 TENTERFIELD 2372  
 Phone: 261657

Current Occupant: UNOCCUPIED  
 Address: ACCESS THROUGH ALEX PERIES PROPERTY  
 Phone: 261429

- ACCESS
- Access Report of 11/18/19 was found suitable/unsuitable.
- 00 P2 TENTERFIELD TRAVE EAST UP MANNERS ST
  - 02 TURN RIGHT SIGN 'LEARN ST'
  - 1.75 TURN LEFT SIGN 'BULLIMBA RD'
  - 5.6 END OF BITUMEN ROAD
  - 7.85 TAKE RIGHT FORK
  - 9.7 PASS ROAD AND STEINBRICK HALL ON LEFT
  - 10.4 PASS ROAD ON LEFT
  - 10.65 PASS ROAD ON RIGHT
  - 14.25 TAKE LEFT FORK
  - 14.9 PASS TRACK OFF TO RIGHT
  - 29.5 TAKE RIGHT FORK
  - 29.7 CROSS ROADS STRAIGHT AHEAD
  - 32.05 PASS BULLIMBA STATION ON LEFT
  - 35.65 TURN RIGHT SIGN UPPER ROCKET RD. WOODBONG
  - 35.95 GRID
  - 36.25 WOODEN BRIDGE
  - 37.55 GRID
  - 38.10 GRID
  - 38.55 PASS FORD ON LEFT
  - 39.45 CAUSEWAY AND NEW FENCE LINE
  - 40.25 GRID
  - 40.75 TURN LEFT ONTO FAINT TRACK TOWARDS RIVER
  - 40.95 CROSS RIVER TURN LEFT HEAD ON BANK
  - 41.10 TURN LEFT THROUGH BRIDGE CROSS CREEK
  - 41.35 CROSS CREEK
  - 41.65 CROSS CREEK
  - 42.55 THROUGH SLIP RAILS AND FOLLOW TRACKS VEERING LEFT
  - 42.75 DRIVE AROUND SPUR AND BETWEEN ROCKS - SIDE SLOPE
  - 42.80 CROSS GULLY AND DRIVE STRAIGHT OVER RIDGE IN FRONT
  - 42.95 TURN RIGHT AND HEAD UP GULLY
  - 43 TURN RIGHT AND DRIVE UP SIDE OF RIDGE STEEP
  - 43.4 TURN LEFT AT TOP OF RIDGE AND DRIVE AS FAR AS FEASIBLE UP CENTRE OF SPUR
  - 43.6 LEAVE VEHICLE AND FOLLOW BEARD TRACK UP SPURS AND THROUGH SADDLES 1 HOUR WALK NO LEAD

This section to be completed by officer constructing pillar.

Original station mark found/~~not found~~

Description of mark: CARTRIDGE CASE IN CONCRETE

Original beacon found/~~not found~~

Description of beacon: CARBON PIPE AND DISCS

Height Top of Vanes to Top Mark: 3.130 m.

Height of mark: 0.000 m above ~~below~~ conc 0.150 m above G.L. below

Diameter of Vanes: 0.070 m. Height of Calm: 1.065 m.

Original Beacon ~~has~~ has not been destroyed by me.

Date	Record of Station
	When done at top of last ridge cross old fence and follow old beamed track to left 1/2 hr walk into lead