

GEODETIC SURVEY OF N.S.W.

CENTRAL MAPPING AUTHORITY

GEODETIC STATION RECONNAISSANCE and MAINTENANCE REPORT

STATION: **MANNA** No.: **2964**
 MAP SHEETS SCALE 1:250 000 SCALE 1:100 000
 INSPECTED BY: **O. MOSS** DATE: **30 Nov 89**
 AUTHORITY: **CMA** FIELD BOOK: **C432**

Station Diagram

Not to Scale

- Description: *Note: Cross out word or words which do not apply*
1. Cleared by lanes bearing nearby 360° from Trig. Mast
 2. Mast & Vanes have been painted white & black respectively.
 3. The station/~~pillar~~ was unplied/~~replaced~~ on 30 Nov 1989, dimensions now being: Brass Plug should be explicit, e.g., S/Steel Pillar Plate, Steel plug, Brass plug, Bolt, G.I. Pipe
- Description of mark.....m. above rock/concrete; Mark is.....m. above G.L.
- Height of Top Vanes to Top Mark/Pillar platem. Diameter of Vanes (vertical).....m.
- Height of Cairn.....m. Diameter of Cairn.....m. Name Plate found/not found/placed.
- Length of Mastm. (approximate if not unplied)
4. A. G.I. Nail set in conc/rock has been placed/~~found~~, bearing.....° M from Mast/Plug/Pillar
 5. A.....set in conc/rock has been placed/found, bearing.....° M from Mast/Plug/Pillar
 6. A.....set in conc/rock has been placed/found, bearing.....° M from Mast/Plug/Pillar
 7. A.....set in conc/rock has been placed/found, bearing.....° M from Mast/Plug/Pillar
8. Action required:.....

STANDPOINT: TRIG PLUG		T2 (Lorc)		STANDPOINT: G.I. Nail in rock			
Mark	Direction	Horiz. Distance	Height Difference	Mark	Direction	Horiz. Distance	Height Difference
BILLYS LOOKOUT (P)	0 00 00		above standpt	BILLYS LOOKOUT (P)	0 00 00		above standpt
DARBY (P)	134 20 06		above standpt	DARBY (P)	134 20 06		above standpt
G.I. Nail in rock	121 15 30	2.459	0.269	Trig Plug	301 15 00	2.457	0.271
			below				below
			above standpt				above standpt
			below				below
			above standpt				above standpt
			below				below
			above standpt				above standpt
			below				below

Prepared by: *Checked*

Checked: *Norman U.T.M. Clark*


STATION MANNA 2964

CO-ORDINATES IN OTHER SYSTEMS

A.N.G. (Clarke 1858) T.M.		INTEGRATED SURVEYS GRID (Central Scale Factor 0.9999)		CASSINI-SOLDNER GRID.	
YARDS	METRES	FEET			
C.M.	C.M.	C.M.			
Zone: 7	Zone: E	Zone: N	Zone: E	Zone: N	Zone: N
576 140.0	870 136.2				
				PROVISIONAL	FINAL
				1613	
				492	

HISTORY OF STATION

Date	Record of Field Action, Marking and Description of Station	Reference
8-12-78	Name Assigned S.A.B. as MANNA	

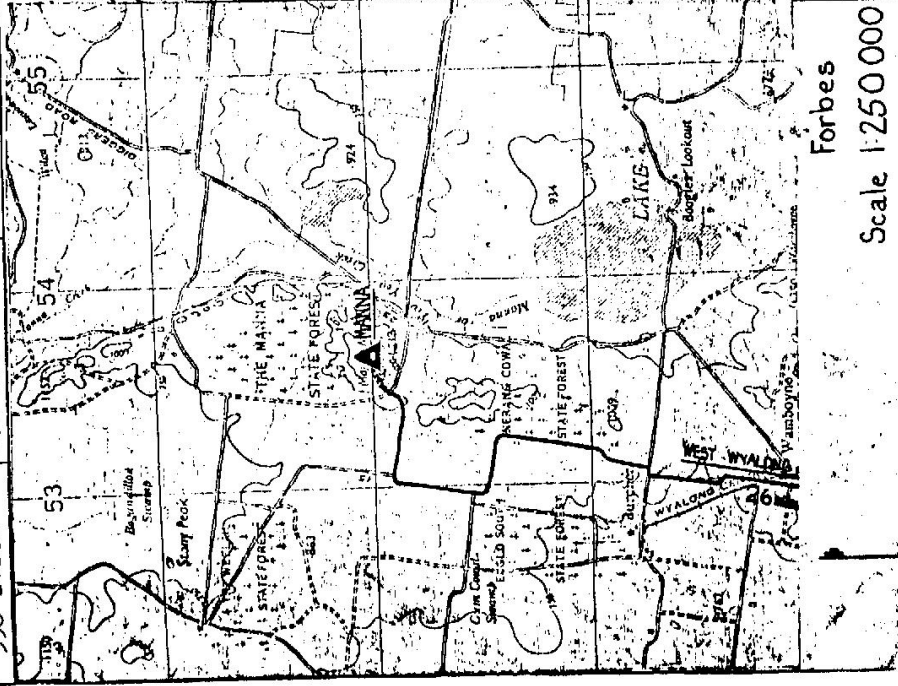

Forbes
Scale 1:250 000