

GEODETIC SURVEY OF N.S.W.

CENTRAL MAPPING AUTHORITY

GEODETIC STATION RECONNAISSANCE and MAINTENANCE REPORT

Description:

1. Cleared by lanes bearing.....
 Note: Cross out word or words which do not apply
 from Trig, Mast

2. Mast & Vanes have been painted white & black respectively.

3. The station/pillar was unpiled/not unpiled/constructed on.....19....., dimensions now being:

Description of mark.....should be explicit, e.g., S/Steel Pillar Plate, Steel plug, Brass plug, Bolt, G.I. Pipe

Height of mark.....m. ^{above} _{below} rock/concrete; Mark is.....m. ^{above} _{below} G.L.

Height of Top Vanes to Top Mark/Pillar platem. Diameter of Vanes (vertical).....m.

Height of Cairn.....m. Diameter of Cairn.....m. Name Plate found/not found/placed.

Length of Mast.....m. (approximate if not unpiled)

4. A.....set in conc/rock has been placed/found, bearing.....° M from Mast/Plug/Pillar

5. A.....set in conc/rock has been placed/found, bearing.....° M from Mast/Plug/Pillar

6. A.....set in conc/rock has been placed/found, bearing.....° M from Mast/Plug/Pillar

7. A.....set in conc/rock has been placed/found, bearing.....° M from Mast/Plug/Pillar

8. Action required:.....

STANDPOINT:

Mark	Direction	Horiz. Distance	Height Difference	Mark	Direction	Horiz. Distance	Height Difference
			above standpt				above standpt
			below				below
			above standpt				above standpt
			below				below
Prepared by:

Checked:

St 2733-1

Noted on U.T.M. Card

STATION: MANDBALAI No.: 2966

MAP SHEET SCALE 1:250 000 SING LELTON

INSPECTED BY: G. C. HANNA DATE: 17/7/78

AUTHORITY: C.M. 4 FIELD BOOK:

Checked

6-2730-2 D. West, Government Printer

STATION MANOBALAI TS 2966	Owner's Name: Address: Phone: Current Occupant: Address: Phone: <p style="text-align: center;">ACCESS</p> Access Report of <u>17.7.1988</u> was found suitable/unsuitable. For access see Manobalai 9033-IV-S Drive to trig 0.3 m. cairn found. Remains of vanes found near cairn. Vision obstructed by hill 600 m. to East of trig
Beacon Diagram 	<p style="text-align: center;">This section to be completed by officer constructing pillar.</p> Original station mark found/not found. Description of mark: Original beacon found/not found. Description of beacon: Height Top of Vanes to Top Mark m. Height of mark m. above rock/conc. m. above G.L. Diameter of Vanes m. below below Height of Cairn m. Original Beacon has/has not been destroyed by me.
Date	Record of Station

CENTRAL MAPPING AUTHORITY

GEODETIC SURVEY OF N.S.W.

GEODETIC STATION RECONNAISSANCE and MAINTENANCE REPORT

STATION: **MANDABALAI**

No.: **2966**


MAP SHEET
SCALE 1:250 000 **SINGLETON**

INSPECTED BY: **J. FANNING**

DATE: **16 Oct 80**

AUTHORITY: **C.M.A. 229 - 229**

FIELD BOOK: **2837**

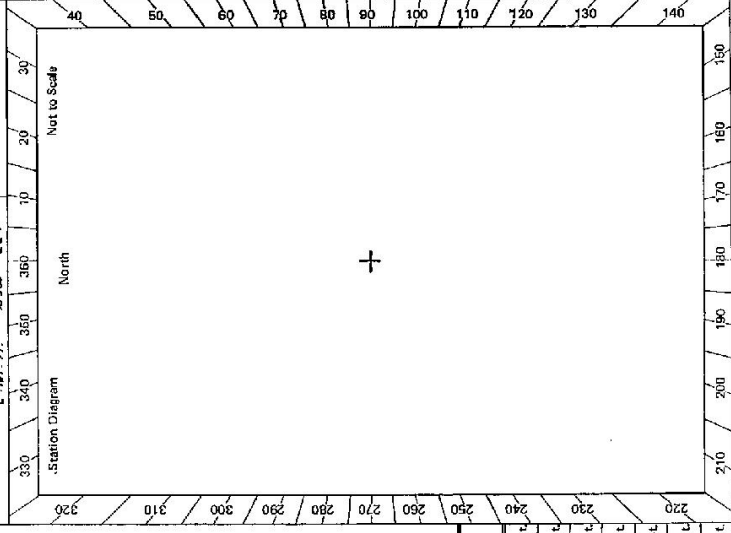


- Description:
- Note: *Cross out word or words which do not apply*
- Cleared by lanes bearing **360°** *Found* from Trig. Mast
 - Mast & Vanes have been ~~replaced~~ **Painted white & black respectively**
 - The station ~~is not unplied~~ **is situated** on **16th Oct 1980**, dimensions now being: Description of mark.....should be explicit, e.g., S/Steel Pillar Plate, Steel plug, Brass plug, Bolt, G.I. Pipe
- Description of mark.....
 Height of mark.....m. above rock/concrete; Mark is.....m. above G.L.
 Height of Top Vanes to Top Mark/Pillar plate.....m. Diameter of Vanes (vertical).....m.
 Height of Cairn.....m. Diameter of Cairn.....m. Name Plate ~~found~~/not found.....
- Length of Mast.....m. (approximate if not unplied)
No witness marks found
- A.....set in conc/rock has been placed/found, bearing.....° M from Mast/Plug/Pillar
 - A.....set in conc/rock has been placed/found, bearing.....° M from Mast/Plug/Pillar
 - A.....set in conc/rock has been placed/found, bearing.....° M from Mast/Plug/Pillar
 - A.....set in conc/rock has been placed/found, bearing.....° M from Mast/Plug/Pillar
8. Action required: *To be Relegated*

STANDPOINT:				STANDPOINT:				
Mark	Card	Direction	Horiz. Distance	Height Difference	Mark	Direction	Horiz. Distance	Height Difference
<i>Distorted</i>				above standpt				above standpt
<i>Spotted Gum</i>		207°	2.9	below				below standpt
<i>Pimple</i>		100	4.0	above standpt				above standpt
<i>Balkan</i>		<i>Not LA visible</i>		below				below standpt
				above standpt				above standpt
				below				below
				above standpt				above standpt
				below				below
				above standpt				above standpt
				below				below

Prepared by: **J. Fanning** Checked: **J. Fanning** *Noted on U.T.M. Card*

et 27932-2 D. West, Government Printer

Beacon Diagram

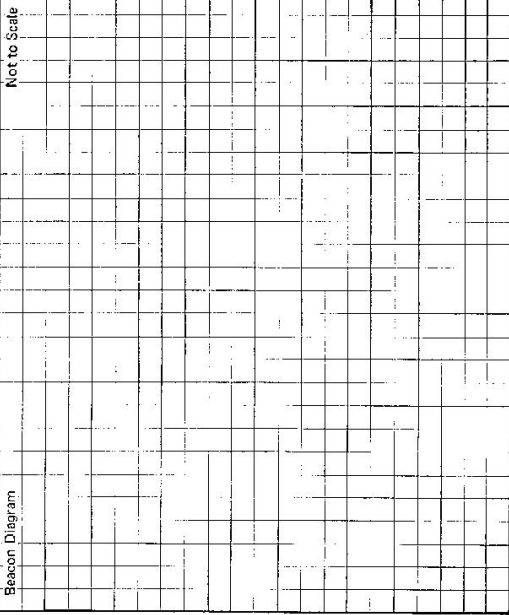

Not to Scale

This section to be completed by officer constructing pillar.

Original station mark found/not found.

Description of mark:

Original beacon found/not found.

Description of beacon:

Height Top of Vane to Top Mark:m.

Height of mark:m. above G.L. below

Diameter of Vane:m.

Height of Cairn:m.

Original Beacon has/has not been destroyed by me.

STATION MANDALAI TS 2966

Owner's Name: Gordon Gallagher Current Occupant:
 Address: The Retreat Address:
 Phone: Wylong Phone:

ACCESS

NO Access Report of 16.1.10/1980 was found unsatisfactory/unavailable.

18.0 Muswellbrook Take Sandy Hollow road
Turn right Signpost
Runner 32
Ridglands 16
Brogheda 7

30.32 Cross culvert over gully
30.38 Grid
37.19 Stop vehicle on top of rise. Trig is 60m to left on rise
Runners House
of 30.02 Take track to right for 1.9km house is "The Retreat"

Date

Record of Station