




TS297

LOCALITY SKETCH PLAN

PROVISIONAL ONLY

Prepared from Trig Card
Date 10-Oct-06

Town/Suburb/Locality **Booligal**
Local Government Area. **Hay**

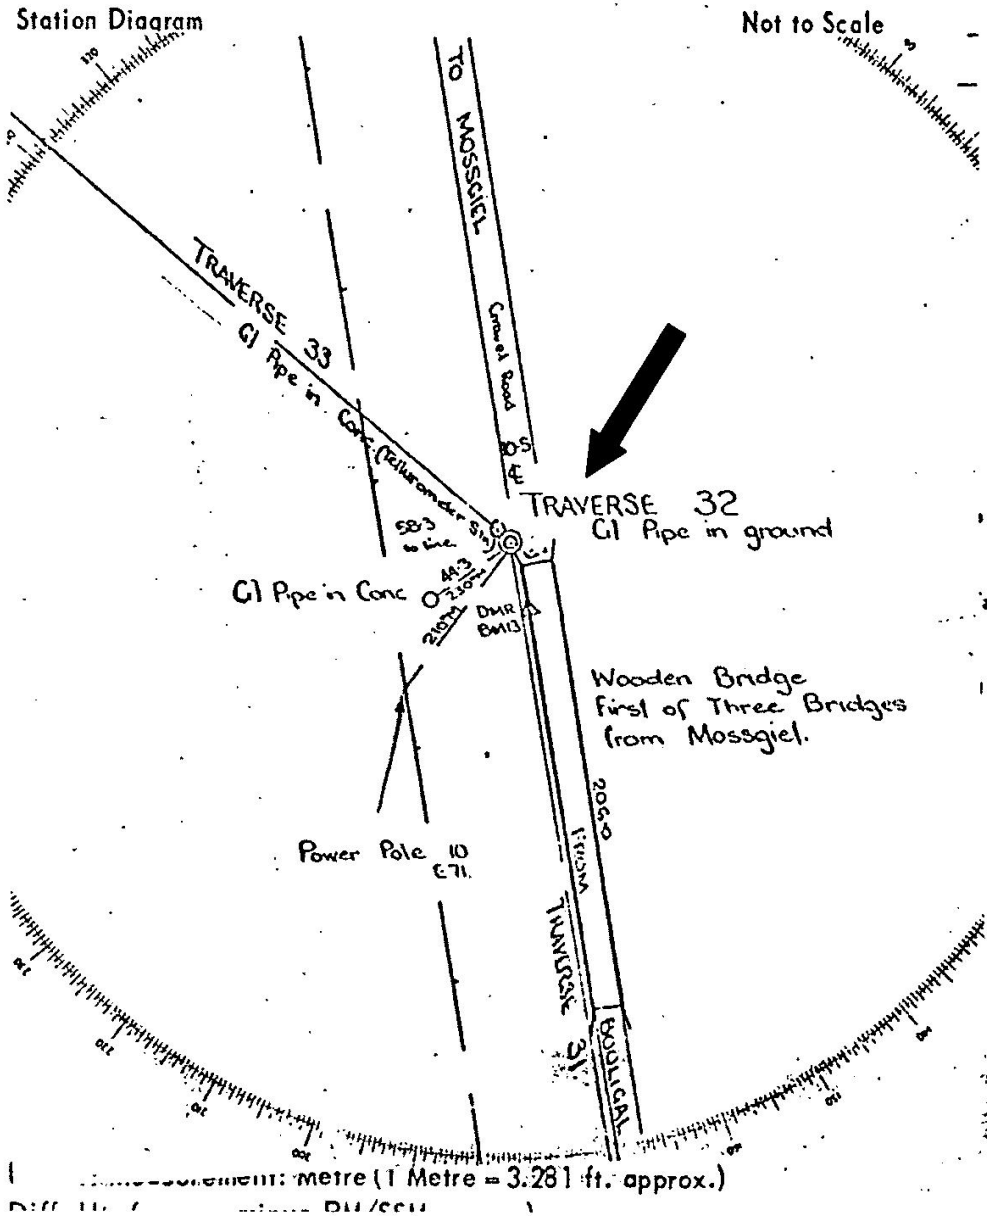

TS 297



TS297

TS297 CMA 3-032

Locality : Booligal

LGA : Hay

