

GEODETTIC SURVEY OF N.S.W.

CENTRAL MAPPING AUTHORITY

GEODETTIC STATION RECONNAISSANCE and MAINTENANCE REPORT

Description: *Note: Cross out word or words which do not apply*

1. Cleared by Janes bearing..... from Trig. Mast
2. Ma. Vancs have been painted white & black respectively.
3. The station/pillar was unpiled/not unpiled/constructed on.....19....., dimensions now being:
 - Description of mark.....should be explicit, e.g., S/Steel Pillar Plate, Steel plug, Brass plug, Bolt, G.I. Pipe
 - Height of mark.....m. ^{above} rock concrete; Mark 's'.....m. ^{above} G.C. _{below}
 - Height of Top Vancs to Top Mark/Pillar plate.....m. Diameter of Vancs (vertical).....m.
 - Height of Cairn.....m. Diameter of Cairn.....m. Name Plate found/not found/placed.
 - Length of Mast.....m. (approximate if not unpiled)
4. A..... ~~set in conc/rock~~ has been placed/found, bearing.....°M from Mast/Plug/Pillar
5. A..... ~~set in conc/rock~~ has been placed/found, bearing.....°M from Mast/Plug/Pillar
6. A..... ~~set in conc/rock~~ has been placed/found, bearing.....°M from Mast/Plug/Pillar
7. A..... ~~set in conc/rock~~ has been placed/found, bearing.....°M from Mast/Plug/Pillar
8. Action required.....

Report

*Trig set in steel condition SSUM IN ROCK FD
 Abg. 1 week to clear hill 300° (small star timber)*

Prepared by:

[Signature] zsh/178

Received UTM Card

STATION: <i>Mares Range G.S.</i>	No.: <i>2975</i>
MAP SHEET SCALE 1:250 000 <i>COBURGEN</i>	DATE: <i>23/11/78</i>
INSPECTED BY: <i>M.L. Morrison</i>	FIELD BOOK: <i>1711</i>
AUTHORITY: <i>CMA</i>	

Station Diagram

Not to Scale

STATION: **TS**
MARES RANGE G.S. 2975


Owner's Name: **W. J. ELLIOTT**
Address: **TARALGA**
Phone:

Current Occupant:

Address Report of **23/11/1978** was found suitable/unsuitable.

Direction
0.00
2.55
3.95
1.55
5.00
5.85
6.00
6.15
7.05
8.05
8.55
8.75
10.45
10.65
11.15

ACCESS
AT INTER. NEAR BARBURN PARK AT INTERSECTION TAKES TAKE ROAD TO
MITTAGONG
PASS RD TO 'TALLY-GANG' ON RIGHT
TURN RIGHT AT TOP OF PASS
GATE 'TALLY-GANG'
PASS TRACK ON RIGHT
GATE
PASS TRACK ON LEFT
GATE
THROUGH GATE TAKE R.H TRACK
GATE
THROUGH GATE TURN RIGHT FOLLOW TRACK
PASS OLD SIGN ON LEFT
TURN RIGHT UP S.W.R
TRNG

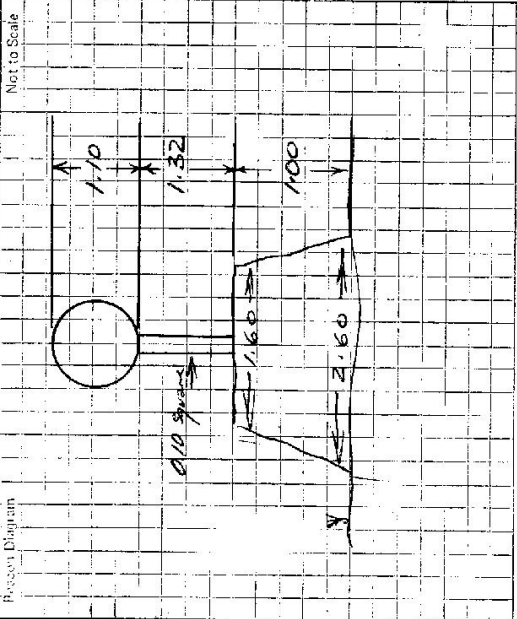

This section to be completed by officer constraining pillar.

Original station marks found/not found.
Description of mark:

Original beacon found/net found.
Description of beacon:

Height Top of Vane to Top Mark.....m.
Height of mark.....m. above G.L. below
Diameter of Vane.....m. Height of Cairn.....m.
Original Beacon has/has not been destroyed by me.

Date	Record of Station