



LOCALITY SKETCH PLAN


PROVISIONAL ONLY

Prepared from Trig Card
Date 10-Oct-06

Town/Suburb/Locality **Booligal**
Local Government Area. **Hay**



TS298

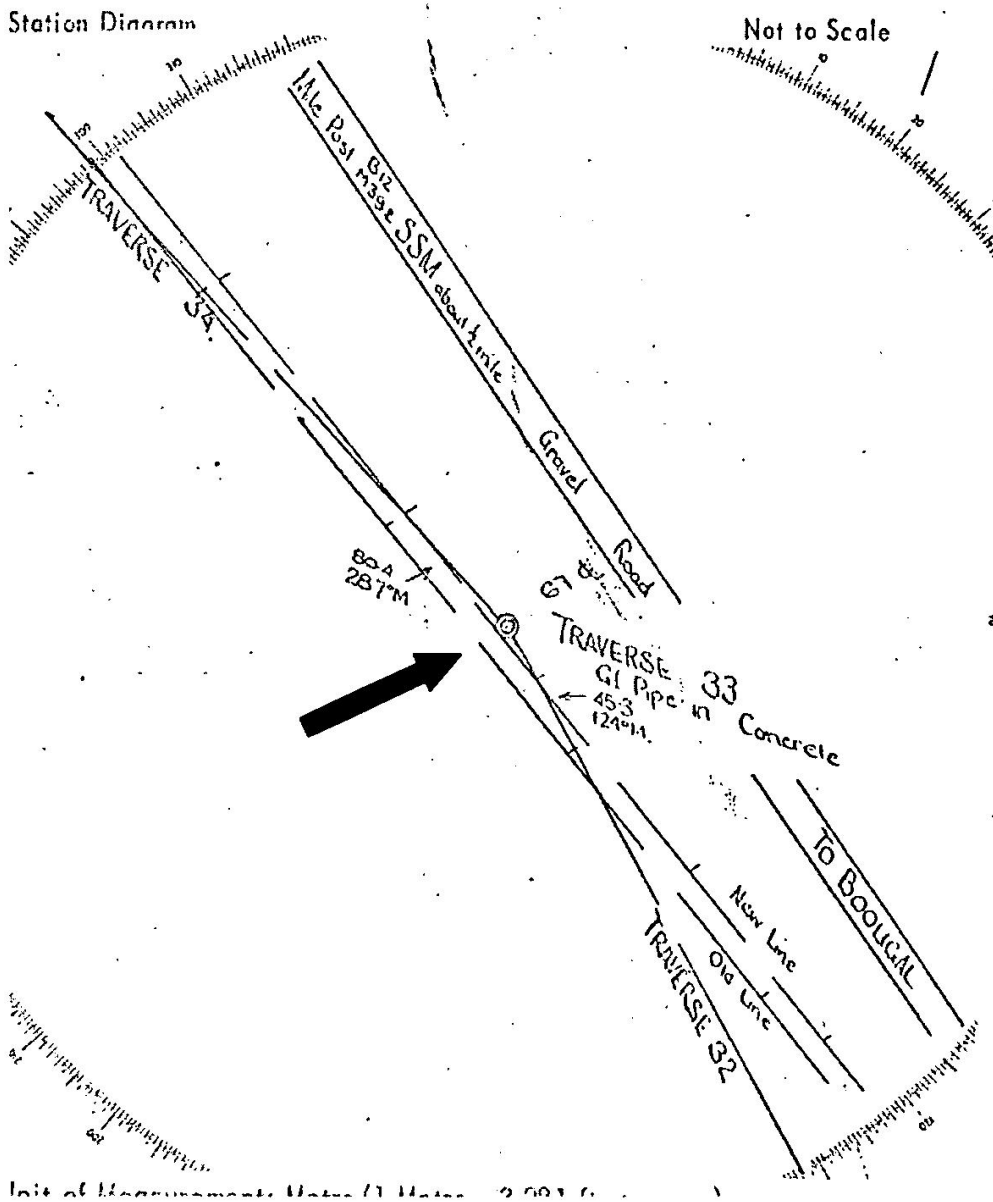

TS 298



TS298

TS298 CMA 3-033

Locality : **Booligal**
LGA : **Hay**

