

MAROBEE
(MARBEE)

CENTRAL MAPPING AUTHORITY
Department of Lands

Trigonometrical Survey of N.S.W.
RECONNAISSANCE and MAINTENANCE REPORT 2984

STATION MAROBEE
Ts 2984
MAROBEE


Co: BLAXLAND Ph: MAROBEE
Map Sheet: KILPARNEY No: 8132
Inspected by: E. GARVIN A.T.S. Date: 16. 4. 75
Authority: INTEGRATION SURVEYS Field Book: NR 381

Beacon Diagram Not to Scale

This Trig. Station has been:

1. Completely cleared to permit 360° vision to surrounding Trig.
2. Cleared by lones bearing 330 to 10 210 from Trig. Mast
3. Trig. Mast & Vanes have been painted white & black respectively.
4. The Trig. was unpiled/rot-unpiled, dimensions now being:
 - Description of mark: brass plug in rock 6 ft. should be explicit, e.g. Steel plug, Brass plug, Bolt, C.I. Pipe
 - Height of mark: 0.04 m above rock/concrete 6 ft.
 - Height of Top Vanes to Top Mark: 3.00 m. Diameter of Vanes (vertical): 0.92 m.
 - Height of Cairn: 1.5 m. Diameter of Cairn: 2.4 m.
 - Length of Mast: 3.04 m. (approximate if not unpiled)
5. A G.I. Pipe set in conc/rock has been placed 12.52 m. bearing 270°M from Trig. Mast
6. A set in conc/soil has been placed m. bearing °M from Trig. Mast
7. A set in conc/soil has been placed m. bearing °M from Trig. Mast
8. A set in conc/rock has been placed m. bearing °M from Trig. Mast
9. Connection to m. bearing °M
10. Connection to m. bearing °M
11. Connection to m. bearing °M
12. Connection to m. bearing °M
13. Diff. Ht. G.I. Pipe is 0.74 m. above Marblee T.S. (top brass plug (A))
14. Diff. Ht. is m. above below
15. Diff. Ht. is m. above below
16. Diff. Ht. is m. above below

Prepared by: E. Garvin A.T.S. Checked: 16/10/75 Noted on U.T.M. Card

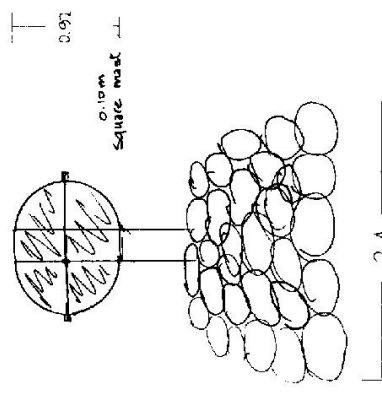


Date	Record of Station

Checked


STATION **MAROBEE** TS 2984

Current Occupant... **G. BARRY**
 Address... **Marobee Homestead**
 via Condobolin N.S.W.

Owners Name... **WESTERN LANDS LEASEHOLD**
 Address.....
 Access **16-4-1975**
 To Nymagoe Colbar
 To "Erenmore" Homestead

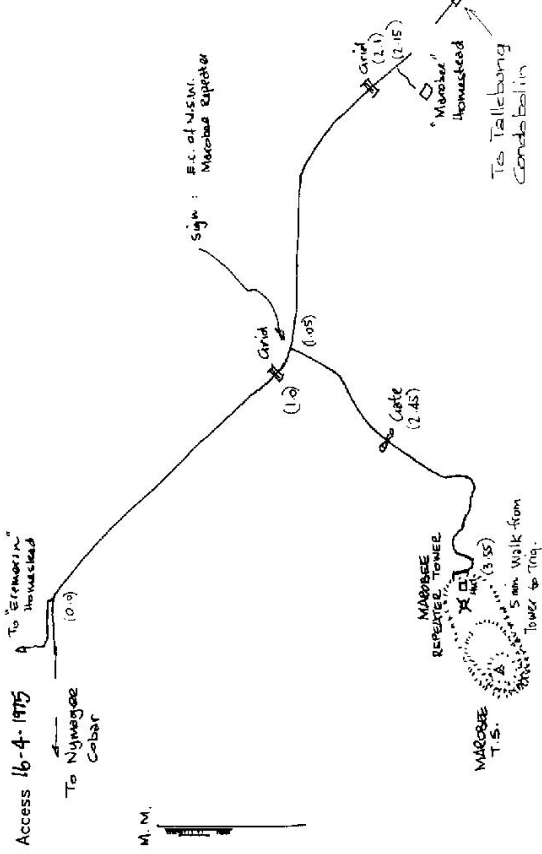

NOT TO SCALE.
 DISTANCES IN MILES.

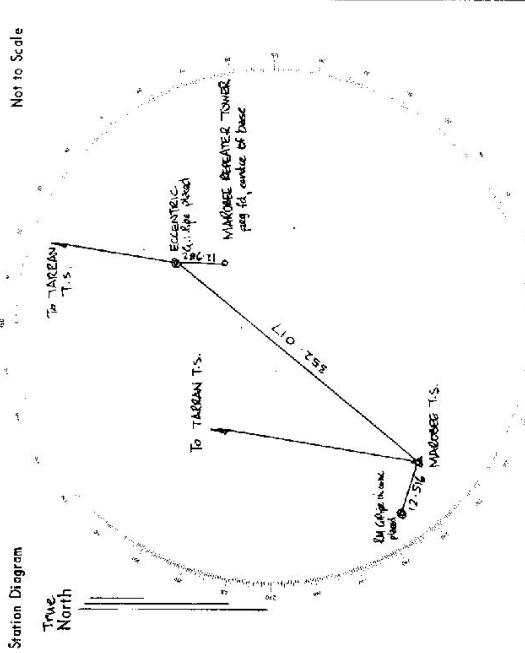

List of Observed Directions:-

Station	Direction	Station	Direction
TAREEAN T.S.	0° 00' 00"	TAREEAN T.S.	0° 00' 00"
G.I. Pipe in GOMC	211° 45' 51"	MAROBEE REPEATER ECCENTRIC	17° 46' 47.4"

Station	Direction	Station	Direction
TAREEAN T.S.	0° 00' 00"	TAREEAN T.S.	0° 00' 00"
TOWER	173° 14' 01"	MAROBEE T.S.	108° 21' 17"