



LOCALITY SKETCH PLAN

PROVISIONAL ONLY

TS299

Prepared from Trig Card


Date 10-Oct-06

Town/Suburb/Locality **Booligal**

Local Government Area. **Hay**

Station Diagram

Not to Scale

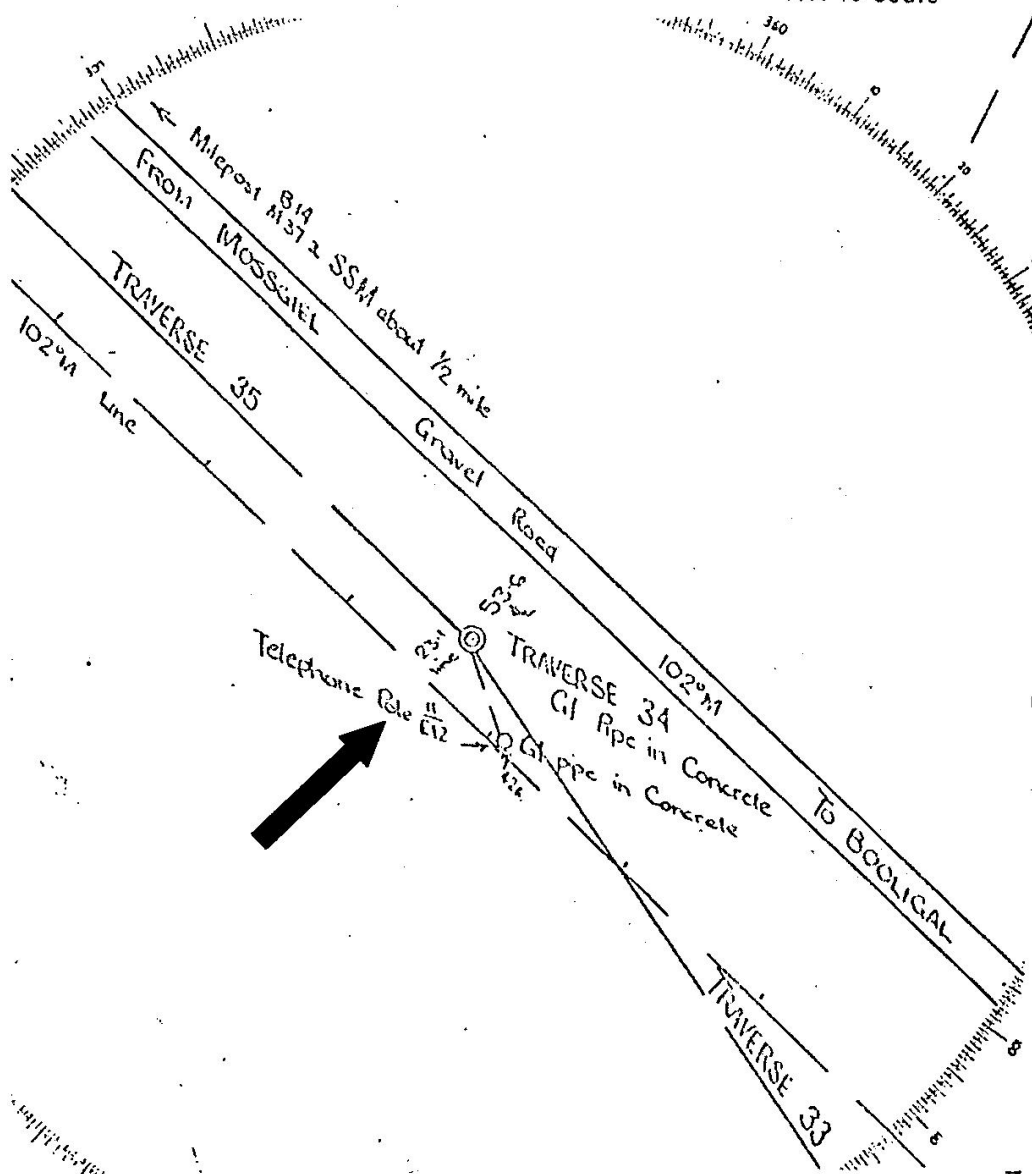

TS 299



TS299

TS299 CMA 3-034

Locality : Booligal

LGA : Hay

