



LOCALITY SKETCH PLAN


PROVISIONAL ONLY



TS300

Prepared from Trig Card
Date 10-Oct-06

Town/Suburb/Locality **Booligal**
Local Government Area. **Hay**

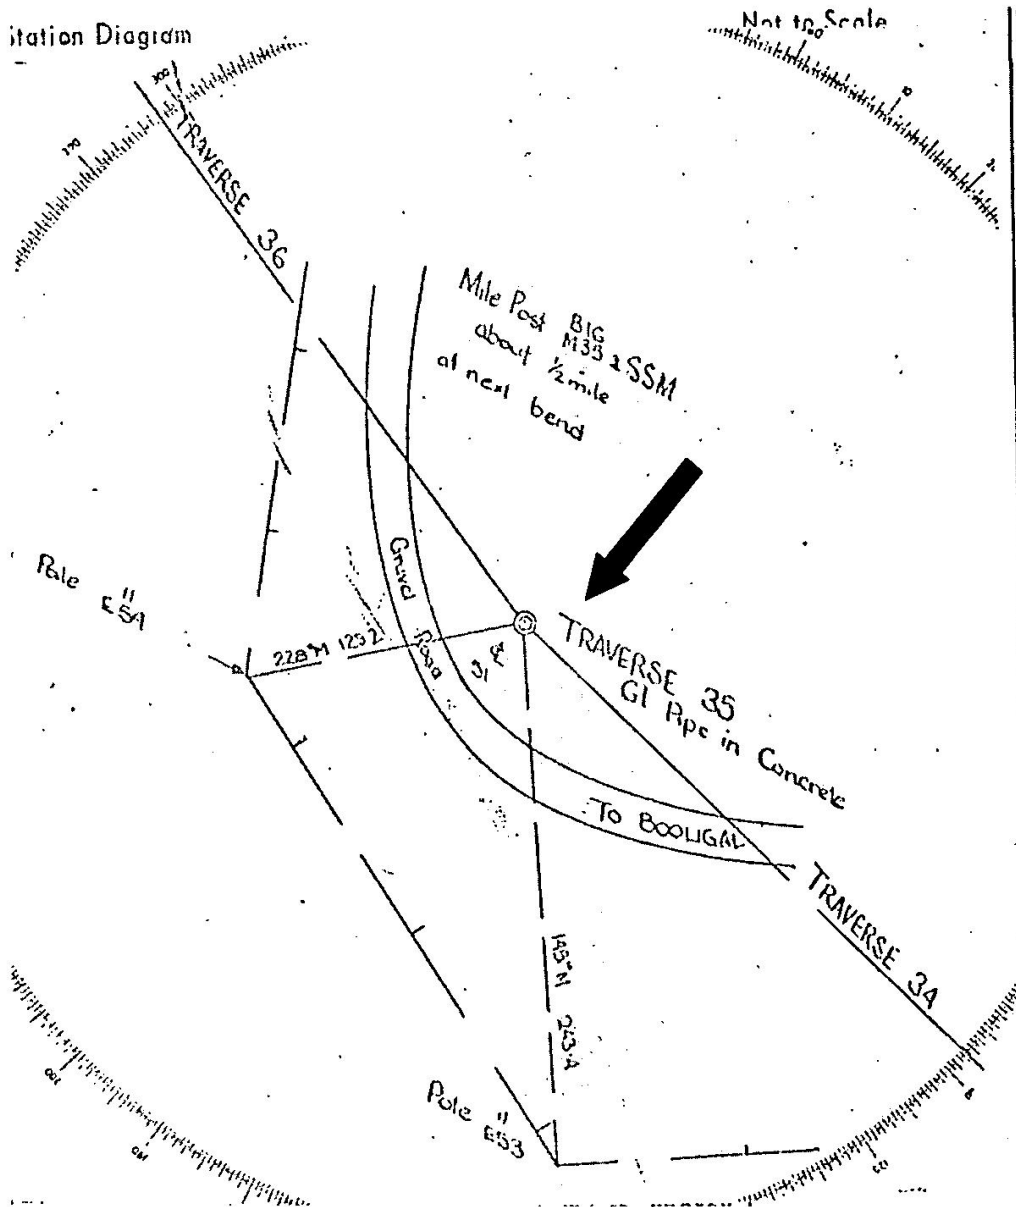

TS 300



TS300

TS300 CMA 3-035

Locality : Booligal

LGA : Hay

