






GEODETTIC SURVEY OF NSAK

CENTRAL MAPPING AUTHORITY

GEODETTIC STATION RECONNAISSANCE and MAINTENANCE REPORT

Description:

1. Cleared by lanes bearing *hill*, *is covered with thick light timber*, *is seen lying on the ground rather* from Trig. Mast  
*Some large trees where old lanes were not cleared about 2-1 day per lane*
  2. Mast & Vanes have been painted white & black respectively.
  3. The station/pillar was unpiled/not unpiled/constructed on ..... 19 ..... dimensions now being:  
*4 gal drum nailed on top of sapling which is now lying on the ground rather*
- Description of mark ..... should be explicit, e.g., S/Steel Pillar Plate, Steel plug, Brass plug, Bolt, G.I. Pipe
- Height of mark ..... m, <sup>above</sup>/<sub>below</sub> rock/concrete; Mark is ..... m, <sup>above</sup>/<sub>below</sub> G.L.
- Height of Top Vanes to Top Mark/Pillar plate ..... m. Diameter of Vanes (vertical) ..... m.
- Height of Cairn ..... m. Diameter of Cairn ..... m. Name Plate found/not found/placed.
- Length of Mast ..... m. (approximate if not unpiled)
4. A ..... set in conc/rock has been placed/found, bearing ..... °M from Mast/Plug/Pillar
  5. A ..... set in conc/rock has been placed/found, bearing ..... °M from Mast/Plug/Pillar
  6. A ..... set in conc/rock has been placed/found, bearing ..... °M from Mast/Plug/Pillar
  7. A ..... set in conc/rock has been placed/found, bearing ..... °M from Mast/Plug/Pillar
8. Action required: *clearing top pillar placed satellite marks* .....

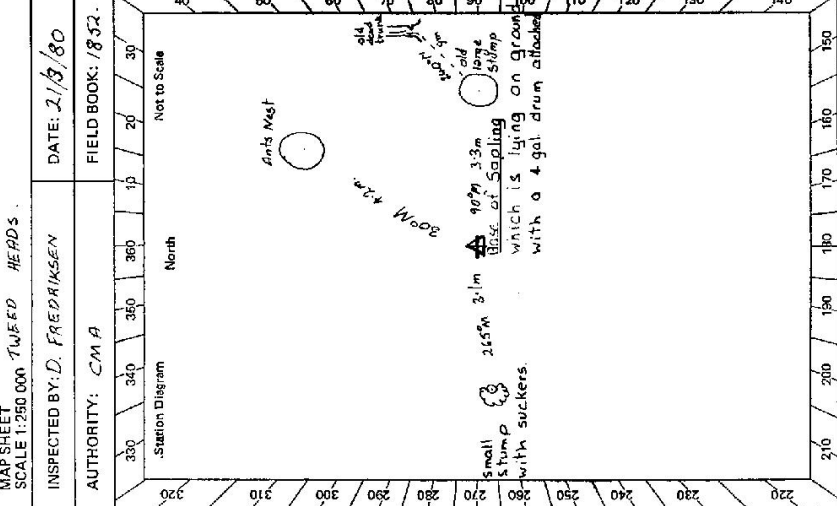

STANDPOINT:

Mark Required	Direction	Horiz. Distance	Height Difference	Mark	Direction	Horiz. Distance	Height Difference
BLUE WOOD	282° 05'		above standpt.				above standpt.
JERUSALEM	62° 35'	Nothing signed	above standpt.				above standpt.
DYAKOX	122° 05'	because of vegetation	below				below
			above standpt.				above standpt.
			below				below
			above standpt.				above standpt.
			below				below
			above standpt.				above standpt.
			below				below

Prepared by: *R.H. Hall*

Checked: *17/4/20*

Checked

