

CENTRAL MAPPING AUTHORITY

GEODETIC SURVEY OF N.S.W.


GEODETIC STATION RECONNAISSANCE and MAINTENANCE REPORT

STATION: *MAPFIELD* No.: *30/2*

MAP SHEET
SCALE 1:250 000 *CANBERRA*

INSPECTED BY: *P.K. BARNOLA* DATE: *MAY 1979*

AUTHORITY: *CMA* FIELD BOOK:

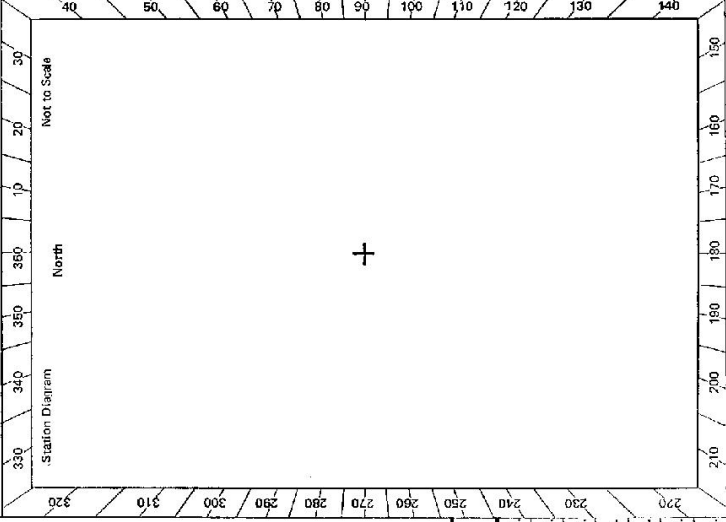

- Description:
1. Cleared by lanes-bearing..... *Timbered* *All* *Revised* *Note: Cross out word or words which do not apply*
..... from Trig. Mast
 2. Mast & Vanes have been painted white & black respectively in case of rocks found
 3. The station/pillar was unspiled/not unspiled/constructed on..... 19..... dimensions now being:
Description of mark..... should be explicit, e.g., S/Steel Pillar Plate, Steel plug, Brass plug, Bolt, G.I. Pipe
Height of mark..... m. ^{above} rock/concrete; Mark is..... m. ^{above} G.L.
Height of Top Vanes to Top Mark/Pillar plate..... m. Diameter of Vanes (vertical)..... m.
Height of Cairn..... m. Diameter of Cairn..... m. Name Plate found/not found/placed.
Length of Mast..... m. (approximate if not unspiled)
 4. A..... set in conc./rock has been placed/found, bearing.....° M from Mast/Plug/Pillar
 5. A..... set in conc./rock has been placed/found, bearing.....° M from Mast/Plug/Pillar
 6. A..... set in conc./rock has been placed/found, bearing.....° M from Mast/Plug/Pillar
 7. A..... set in conc./rock has been placed/found, bearing.....° M from Mast/Plug/Pillar
 8. Action required: *3 days clearing - Station suitable for use*

STANDPOINT:			
Mark	Direction	Horiz. Distance	Height Difference
			above standpt.
			below standpt.
			above standpt.
			below standpt.
Prepared by: *P.K. Barnola 27/6/79* Checked: *Checked*
Noted on U.T.M. Card

CENTRAL MAPPING AUTHORITY

GEODETIC SURVEY OF N.S.W.

GEODETIC STATION RECONNAISSANCE and MAINTENANCE REPORT

Description:

1. Cleared by-lanes-bearing..... *Timbered All* from Trig. Mast
Note: Cross out word or words which do not apply
2. Mast & Vanes have been painted white & black respectively. in case of rocks found
3. The station/pillar was unpiled/not unpiled/constructed on 19....., dimensions now being:
 Description of mark..... should be explicit, e.g., S/Steel Pillar Plate, Steel plug, Brass plug, Bolt, G.I. Pipe
 Height of mark.....m. ^{above} rock/concrete; Mark ism. ^{above} G.I.
 Height of Top Vanes to Top Mark/Pillar platem. Diameter of Vanes (vertical).....m.
 Height of Cairn.....m. Diameter of Cairn.....m. Name Plate found/not found/placed.
 Length of Mastm. (approximate if not unpiled)
4. A..... set in conc/rock has been placed/round, bearing.....° M from Mast/Plug/Pillar
5. A..... set in conc/rock has been placed/round, bearing.....° M from Mast/Plug/Pillar
6. A..... set in conc/rock has been placed/round, bearing.....° M from Mast/Plug/Pillar
7. A..... set in conc/rock has been placed/round, bearing.....° M from Mast/Plug/Pillar
8. Action required: *Re-align Cairn. Station. Re-locate for pillar construction*

STANDPOINT:

Mark	Direction	Horiz. Distance	Height Difference	Mark	Direction	Horiz. Distance	Height Difference
			above standpt.				above standpt.
			below standpt.				below standpt.
			above standpt.				above standpt.
			below standpt.				below standpt.
			above standpt.				above standpt.
			below standpt.				below standpt.
			above standpt.				above standpt.
			below standpt.				below standpt.

Prepared by: *P.K. Bannath 27/6/22* Checked:

Noted on U.T.M. Card

Checked

Sr. 2733-1

STATION: *MAYFIELD* No: *3012*
 MAP SHEET: *CANBERRA*
 SCALE 1:250 000
 INSPECTED BY: *PICBAMOLA* DATE: *MAY 1979*
 AUTHORITY: *CMA* FIELD BOOK:

