


TS 3020
 STATION M^c CUE T.S. 3020
 Co: CUMBERLAND Ph:
 Map Sheet: BLACKTOWN 1/10000 No: 9160
 Inspected by: J. KWASNJICA Date: 31/5/77
 Authority: ISD Field Book: 585/6.

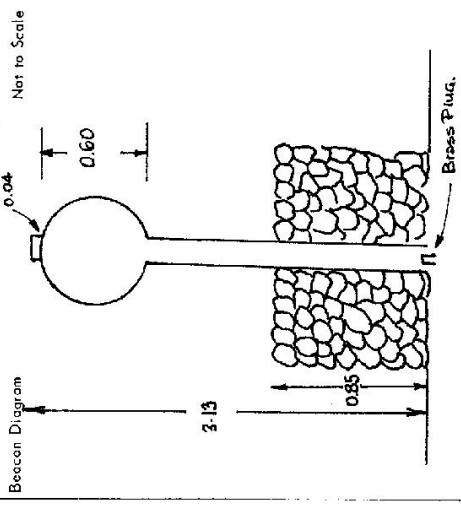

Department of Lands
 Integral survey of N.S.W.
 RECONNAISSANCE and MAINTENANCE REPORT

This Trig. Station has been: Note: Cross out word or words which do not apply

1. Completely cleared to permit 360° vision to surrounding Trigs.
2. Cleared by limes bearing..... from Trig. Mast
3. Trig. Mast & Vanes have been painted white & black respectively.
4. The Trig. was unpiled/not unpiled, dimensions now being: **Plug found to be loose.**

Description of mark: **Brass Plug** should be explicit, e.g. Steel plug, Brass plug, Bolt, Concrete Pillar
 Height of mark: m above rock/concrete m above G.L.
 Height of Top Vanes to Top Mark/Top pillar plate: **3.13** m Diameter of Vanes (vertical): **0.60** m.
 Height of Cairn: **0.85** m. Diameter of Cairn: **0.90** m.
 Length of Mast: **3.13** m. (approximate if not unpiled)

5. A..... set in conc./rock has been placed/fd m. bearing°M from Trig. Mast/pillar
6. A..... set in conc./soil has been placed/fd m. bearing°M from Trig. Mast/pillar
7. A..... set in conc./soil has been placed/fd m. bearing°M from Trig. Mast/pillar
8. A..... set in conc./rock has been placed/fd m. bearing°M from Trig. Mast/pillar

9. Connection..... to..... m. bearing°M
10. Connection..... to..... m. bearing°M
11. Connection..... to..... m. bearing°M
12. Connection..... to..... m. bearing°M
13. Diff. Ht. is m. above/below
14. Diff. Ht. is m. above/below
15. Diff. Ht. is m. above/below
16. Diff. Ht. is m. above/below

Prepared by: *Jillian Kwasnjica* Checked: *16/6/77* *S. Byrnes*

Date: *31/5/77* Record of Station
Connected to traverse, repiled

STATION **MCCLUE T.S. 3020**
(Conserved)

Owners Name:
 Current Occupant:
 Address:
 Address:

Access 31/5/1977

Access: UBD 36 E4
 Conventional drive track,
 Men walk from end of driveway
 about 200m to the station

D. West, Government Printer, New South Wales - 1976

