



LOCALITY SKETCH PLAN


PROVISIONAL ONLY



TS303

Prepared from Trig Card
Date 10-Oct-06

Town/Suburb/Locality **Booligal**
Local Government Area. **Hay**

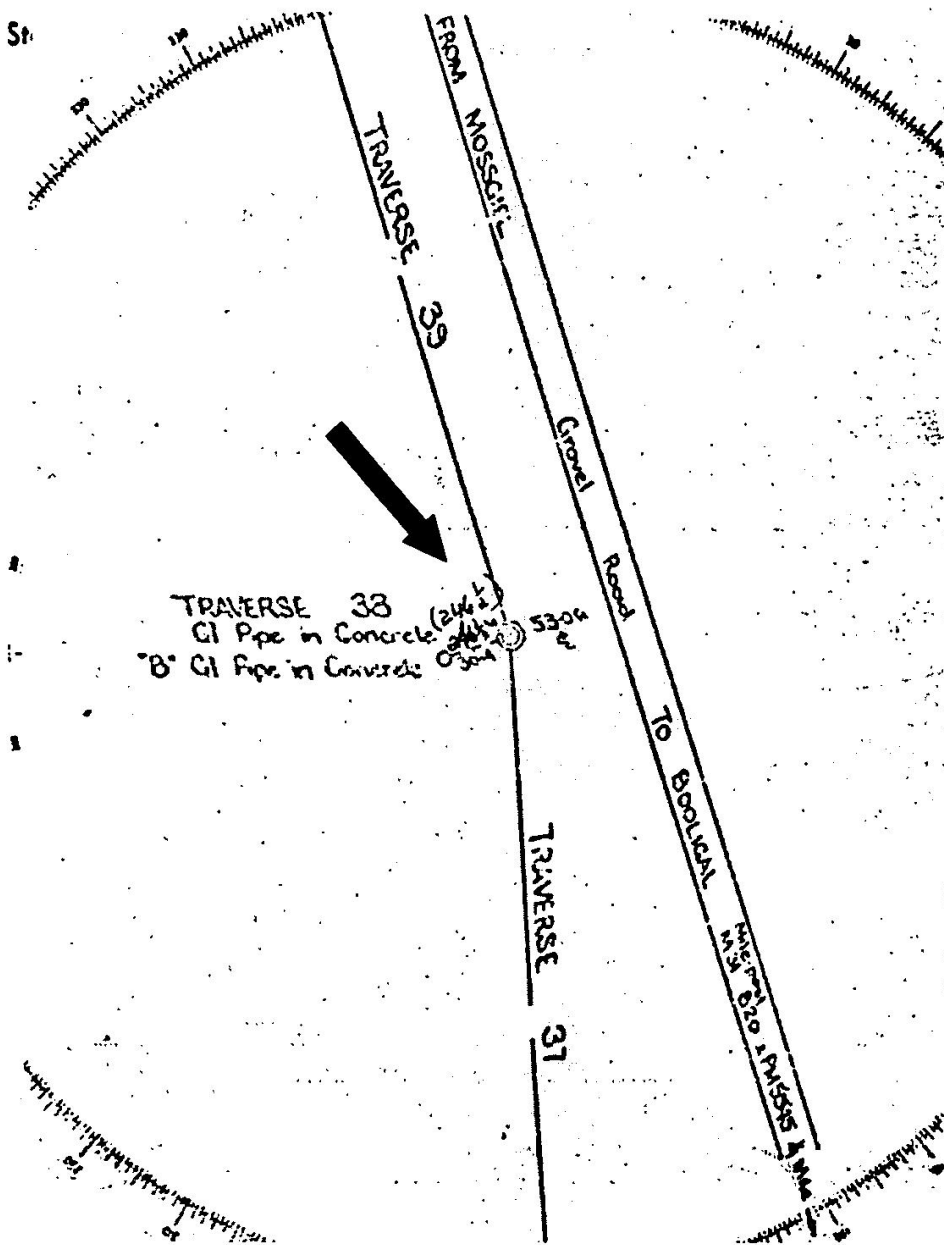

TS 303



TS303

TS303 CMA 3-038

Locality : Booligal

LGA : Hay

