

CENTRAL MAPPING AUTHORITY

GEODETIC SURVEY OF N.S.W.

GEODETIC STATION RECONNAISSANCE and MAINTENANCE REPORT

Description:

1. Cleared by lanes bearing.....
 Note: *Cross out word or words which do not apply*
 from Trig. Mast

2. Mast & Vanes have been painted white & black respectively.

3. The station/~~pillar~~ was unpiled/~~not unpiled~~/~~constructed~~ on.....*19.7.77* dimensions now being:

Description of mark.....should be explicit, e.g., S/Steel Pillar Plate, Steel plug, Brass plug, Bolt, G.I. Pipe

Height of mark.....*0.03* m. ^{above} rock/~~concrete~~; Mark is *0.30* m. ^{below} ~~set~~ *Rock*.

Height of Top Vanes to Top Mark/Pillar platem. Diameter of Vanes (vertical).....m.

Height of Cairn.....m. Diameter of Cairn.....m. Name Plate found/not found/placed.

Length of Mastm. (approximate if not unpiled)

4. A.....set in conc/rock has been placed/found, bearing.....° M from Mast/Plug/Pillar

5. A.....set in conc/rock has been placed/found, bearing.....° M from Mast/Plug/Pillar

6. A.....set in conc/rock has been placed/found, bearing.....° M from Mast/Plug/Pillar

7. A.....set in conc/rock has been placed/found, bearing.....° M from Mast/Plug/Pillar

8. Action required:.....*POSSIBLE SITE FOR STEEL PILLAR. Remains of cairn only found*

STANDPOINT:

Mark	Direction	Horiz. Distance	Height Difference	Mark	Direction	Horiz. Distance	Height Difference
			above standpt.				above standpt.
			below				below
			above standpt.				above standpt.
			below				below
Prepared by:

P. Naylor 08.78

Noted on U.T.M. Card

Checked

SI 2733-1

STATION: *M^s PHERSON* No: *3036*
 MAP SHEET SCALE 1:250 000 *NARRANDERA*
 INSPECTED BY: *P. Naylor* DATE: *14.7.77*
 AUTHORITY: *C.M.A.* FIELD BOOK:

STATION M' PIERSON TS 3036	Owner's Name: TELE RESERVE (M.P.C) Address: 10-80 St. M's 767 Uge. Phone: Current Occupant: Mr A F Savaris, R. 453 Address: Schneider Banna Ave Phone: Mr. R. Griffith, R. 453 Confed N.E.L. Griffith.	
Beacon Diagram Not to Scale		
Access Report of Mt. 7/19K was found suitable/unavailable. MARRANDERA 1:250,000 MAP REFERENCE 409/778		
This section to be completed by officer constructing pillar. Original station mark found/not found. Description of mark: Original beacon found/not found. Description of beacon: Height Top of Vane to Top Mark m. Height of mark m. above G.L. / below rock/conc. Diameter of Vane m. Height of Cairn m. Original Beacon has/has not been destroyed by me.		
Date	Record of Station	

CENTRAL MAPPING AUTHORITY

GEODETIC SURVEY OF M.S.W.

GEODETIC STATION RECONNAISSANCE and MAINTENANCE REPORT

Description:

1. Cleared by lances bearing..... *Note: Cross out word or words which do not apply*
2. Mast & Vanes have been painted white & black respectively. (no mast or vanes)
3. The station/~~plate~~ was unplaced/~~was unplaced~~..... 13/3/78..... 19..... dimensions now being:
Description of mark: **Brass. Plug** should be explicit, e.g., S/Steel Pillar Plate, Steel plug, Brass plug, Bolt, G.I. Pipe
Height of mark.....m. above rock/concrete; Mark is.....m. above G.L.
- Height of Top Vanes to Top Mark/Pillar plate.....m. Diameter of Vanes (vertical).....m.
- Height of Cairn.....~~0.3 (fallen down)~~.....m. Diameter of Cairn.....1.0.....m. Name Plate ~~found~~ not found/~~placed~~
- Length of Mast.....m. (approximate if not unplaced)
4. A.....set in conc/rock has been placed/ found, bearing.....°M from Mast/Plug/Pillar
5. A.....set in conc/rock has been placed/ found, bearing.....°M from Mast/Plug/Pillar
6. A.....set in conc/rock has been placed/ found, bearing.....°M from Mast/Plug/Pillar
7. A.....set in conc/rock has been placed/ found, bearing.....°M from Mast/Plug/Pillar
8. Action required: **Cairn needs rebuilding and requires new mast.**

STANDPOINT:

Mark	Direction	Horiz. Distance	Height Difference	Mark	Direction	Horiz. Distance	Height Difference
			above standpt.				above standpt.
			below				below
			above standpt.				above standpt.
			below				below
Prepared by:

Checked:

St 2733-1

Noted on U.T.M. Card

STATION: McPHERSON

MAP SHEET SCALE 1:250 000 NARANDERA

INSPECTED BY: R.B. MOONEY

DATE: 13/3/1978

AUTHORITY:

FIELD BOOK:

TK No.: 3036

Checked

6

8t-2733--2 0 Beacon Dis:	Government Printer	Not to Scale	STATION <u>Mc Pherson</u> TS <u>3036</u> Owner's Name: Address: Phone: Current Occupant: Address: Phone: ACCESS Access Report of <u>13.5.1978</u> was found suitable/unsuitable. A short steep climb is necessary from the western side of the station where there is a hole in the cliff face (this hole can be seen from the track when you come through the fence.)
This section to be completed by officer constructing...			Record of Station
Original station mark found/not found. Description of mark: Original beacon found/not found. Description of beacon: Height Top of Vanes to Top Markm. Height of markm. above rock/stonem. below G.L. Diameter of Vanesm. Height of Cairnm. Original Beacon has/has not been destroyed by me.			

GEODEIC SURVEY OF N.S.W.

CENTRAL MAPPING AUTHORITY

GEODEIC STATION RECONNAISSANCE and MAINTENANCE REPORT


- Description:**
- Cleared by Janes bearing $160^{\circ} 34'$ 135.24 m.
 Note: Cross out word or words which do not apply
 - Mast & Vanes have been painted white & black respectively.
 - The station/pillar was unpiled/not unpiled/constructed on 1978 16319 , dimensions now being:
 Description of mark 16319 should be explicit, e.g., S/Steel Pillar Plate, Steel plug, Brass plug, Bolt, G.I. Pipe
 - Height of mark 0.34 m. ^{above} rock/concrete; Mark is 0.34 m. ^{above} G.L.
 - Height of Top Vanes to Top Mark/Pillar plate 2.3 m. ^{above} Diameter of Vanes (vertical) 1.0 m.
 - Height of Cairn 1.1 m. Diameter of Cairn 1.3 m. ^{at top} Name Plate found/not found/placed.
 - Length of Mast 3.67 m. (approximate if not unpiled)
 - A 1.4 m. ^{set in conc/rock} has been placed/found, bearing $142^{\circ} 00'$ M from West/Plug/Pillar
 - A 1.4 m. ^{set in conc/rock} has been placed/found, bearing $142^{\circ} 00'$ M from Mast/Plug/Pillar
 - A 1.4 m. ^{set in conc/rock} has been placed/found, bearing $142^{\circ} 00'$ M from Mast/Plug/Pillar
 - A 1.4 m. ^{set in conc/rock} has been placed/found, bearing $142^{\circ} 00'$ M from Mast/Plug/Pillar
 - Action required: 1.4 m. ^{set in conc/rock} has been placed/found, bearing $142^{\circ} 00'$ M from Mast/Plug/Pillar

Mark	Direction	Horiz. Distance	Height Difference	Mark	Direction	Horiz. Distance	Height Difference
BOND G.S. Trig Plug	$100^{\circ} 00' 00''$		above standpt.	BOND G.S. Trig Plug	$100^{\circ} 00' 25''$		above standpt.
JONDARVAN OP	$57^{\circ} 05' 00''$		below standpt.	JONDARVAN G.S.	$57^{\circ} 06' 25''$		below standpt.
Copper Nail in Conc.	$06^{\circ} 03'$	4.006	above standpt.	G.I. Pipe in Conc.	$141^{\circ} 57'$	5.875	above standpt.
G.I. Pipe in Conc.	$99^{\circ} 02'$	4.032	above standpt.	Trig Plug	$186^{\circ} 01'$	4.007	below standpt.
			below standpt.				above standpt.
			above standpt.				below standpt.
			below standpt.				above standpt.
			above standpt.				below standpt.

STANDPOINT: Brass Trig Plug. STANDPOINT: Copper Nail in Conc.

Prepared by: Sham Woodruff Checked: A Woodruff

Noted on U.T.M. Card

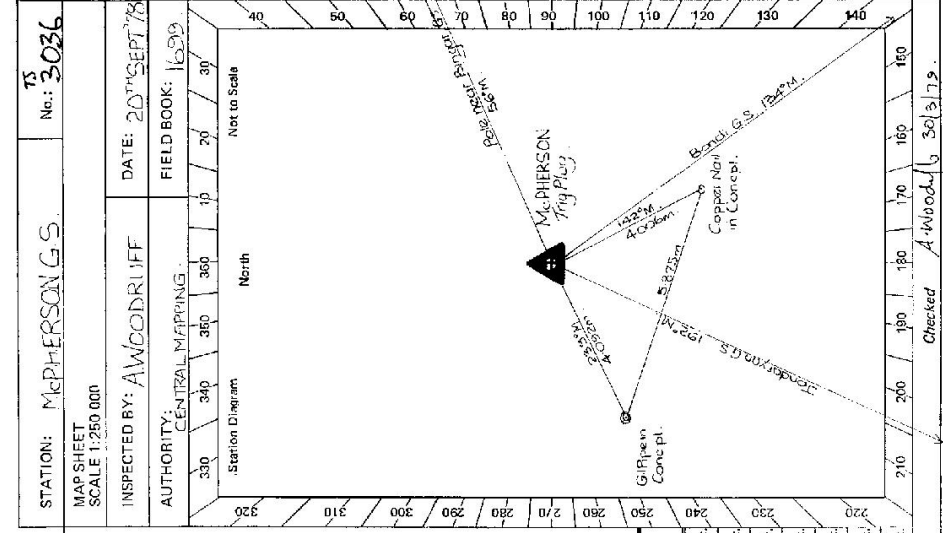

STATION: McPHERSON G.S. No.: 3036

MAP SHEET SCALE 1:250 000

INSPECTED BY: A WOODRUFF DATE: 20TH SEPT 78

AUTHORITY: CENTRAL MAPPING FIELD BOOK: 16319

Station Diagram

North

Not to scale

Checked: A Woodruff 30/3/79

S: 2733-2 D. West, Government Printer

STATION **McPHERSON G.S. TS 3036**

Owner's Name: **TRIG RANGERS (NRC)** Current Occupant:

Address: **10-00 ac M^s 707 D³g⁶** Address:

Phone: Phone:

ACCESS

Access Report of **2017/1928** was found suitable/unsuitable. **Alternate access available.**

From Griffith proceed NE to Beelbongera P.O.

0.0 Km Head North from P Office.


0.19 Km Turn left at intersection on road to Rankin Springs

5.69 Km Turn left onto gravel/dirt road and through gate.

6.72 Kms Go through gate

8.37 Kms Go through gate - keep to the right hand track.

9.86 kms Stop at fence intersection - walk up to Trig through a break in cliff face.

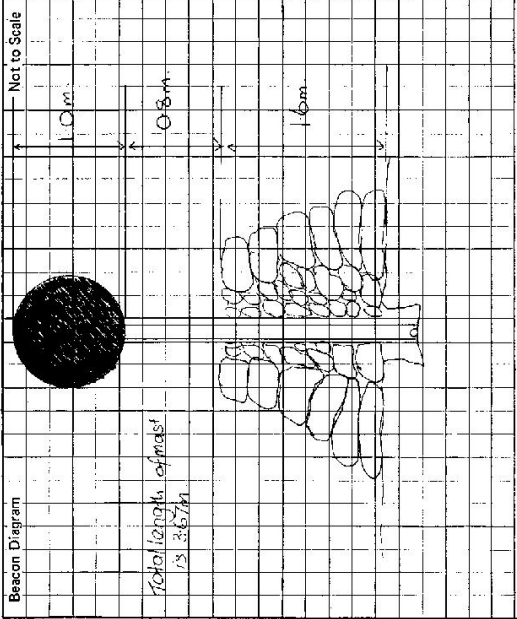

This section to be completed by officer constructing pillar.

Original station mark found/~~not found~~.

Description of mark: **BRASS Trig Pillar**

Original beacon found/~~not found~~.

Description of beacon:

Height Top of Vanes to Top Markm.

Height of markm above G.L. / below rock/cont.m.

Diameter of Vanesm. Height of Cairnm.

Original Beacon has/~~has not~~ been destroyed by me.

Date	Record of Station