

LAND INFORMATION CENTRE

GEODETTIC SURVEY OF A.S.M.


GEODETTIC STATION RECONNAISSANCE and MAINTENANCE REPORT

- Description:
- Cleared by lanes bearing..... Note: Cross out word or words which do not apply
 - Mast & Vanes have been painted white & black respectively. from Trig. Mast
 - The station/pillar was unpiled/not unpiled/constructed on..... 19....., dimensions now being:
 - Description of mark..... should be explicit, e.g., S/Steel Pillar Plate, Steel plug, Brass plug, Bolt, G.I. Pipe
 - Height of mark.....m, above below rock/concrete; Mark is.....m, above G.L.
 - Height of Top Vanes to Top Mark/Pillar platem. Diameter of Vanes (vertical).....m.
 - Height of Cairn.....m. Diameter of Cairn.....m. Name Plate found/not found/placed.
 - Length of Mastm. (approximate if not unpiled)
 - A.....set in conc/rock has been placed/ found, bearing.....° M from Mast/Plug/Pillar
 - A.....set in conc/rock has been placed/ found, bearing.....° M from Mast/Plug/Pillar
 - A.....set in conc/rock has been placed/ found, bearing.....° M from Mast/Plug/Pillar
 - A.....set in conc/rock has been placed/ found, bearing.....° M from Mast/Plug/Pillar
 - Action required:.....

STANDPOINT: *Nail in Dummy FeL.*

Mark	Direction	Horiz. Distance	Height Difference	Mark	Direction	Horiz. Distance	Height Difference
<i>BOOTHUMBLE 65</i>	<i>0 00 00</i>		<i>above standpt.</i>				<i>above standpt.</i>
<i>2 Mast (Plugs)</i>	<i>116 31</i>	<i>5.16</i>	<i>0.60</i>				<i>above standpt.</i>
<i>SSM 65309</i>	<i>192 1550</i>		<i>above standpt.</i>				<i>above standpt.</i>
			<i>below</i>				<i>below</i>
			<i>above standpt.</i>				<i>above standpt.</i>
			<i>below</i>				<i>below</i>
			<i>above standpt.</i>				<i>above standpt.</i>
			<i>below</i>				<i>below</i>
			<i>above standpt.</i>				<i>above standpt.</i>
			<i>below</i>				<i>below</i>

Prepared by: *M Morrison 11/06/94* Checked: *Noted on U.T.M. Card*

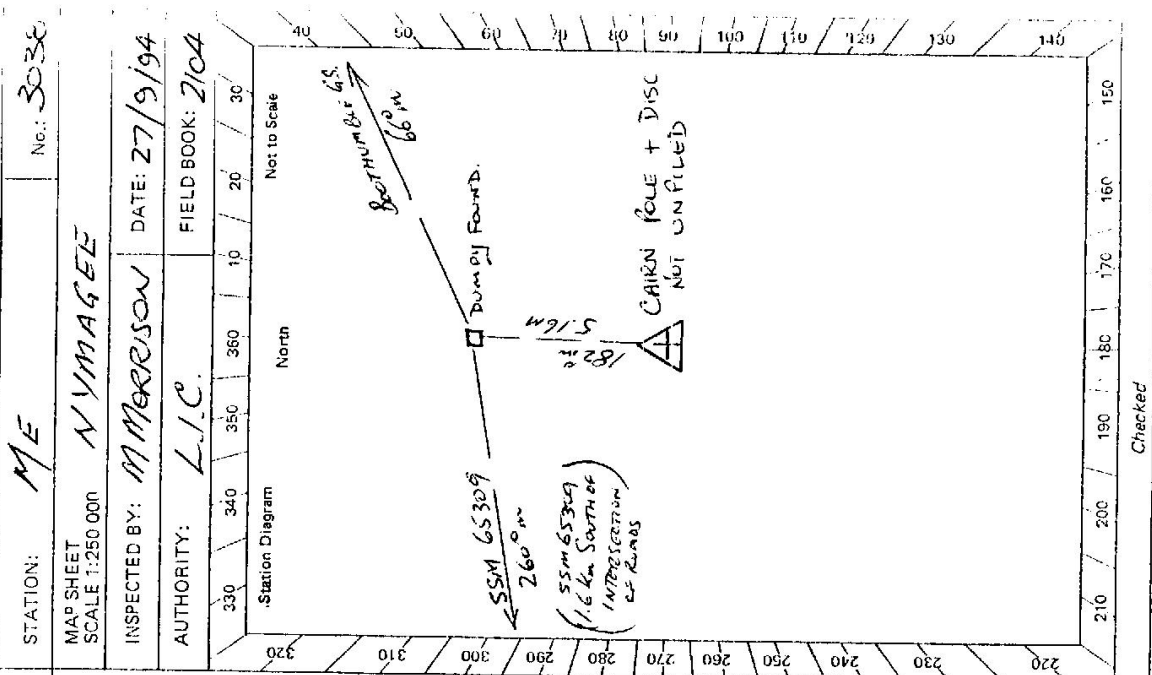


STATION **ME** **3038**

Owner's Name:
 Address:
 Phone:
 Current Occupant:
 Address:
 Phone:

ACCESS

Access Report of...../19.....was found suitable/unsuitable. "
 " **ON THE ROUND HILL**
IN ROUND HILL NATURE RESERVE APPROX 30 km
EAST OF MOUNT HOPE ON THE EQUIBALONG WEST ROAD.

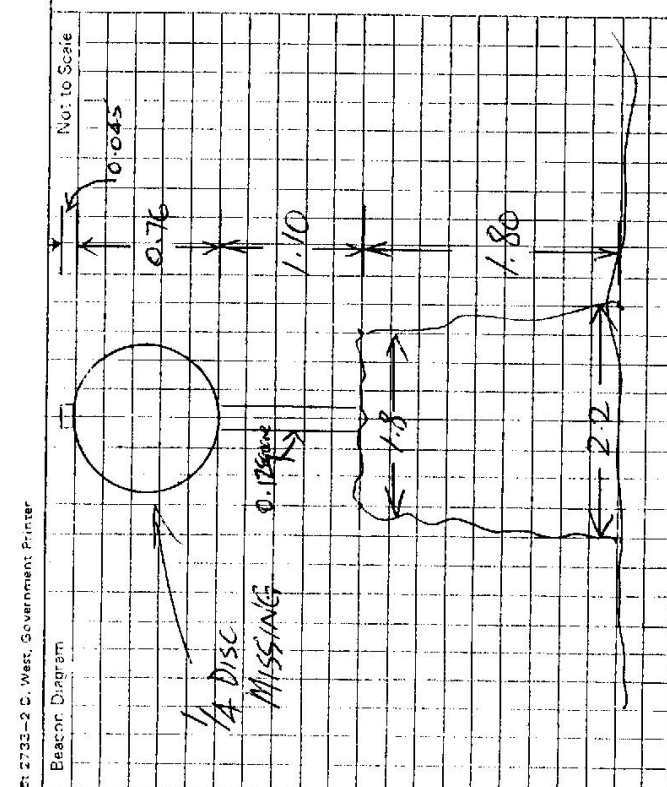

This section to be completed by officer constructing pillar.

Original station mark found/not found.

Description of mark:

Original beacon found/not found.

Description of beacon:

Height: Top of Vanes to Top Markm.

Height of mark.....m. above rock/concm. above G.L. below

Diameter of Vanesm. Height of Cairnm.

Original Beacon has/has not been destroyed by me.

Date	Record of Station

LAND INFORMATION CENTRE

GEODETTIC SURVEY OF N.S.W.

GEODETTIC STATION RECONNAISSANCE and MAINTENANCE REPORT

Batch 1668

STATION: M E

No.: 3038

Description:

1. Cleared by lanes bearing 240° ~~205.0~~ M. ~~205.0~~ M. from Trig. Mast
Note: Cross out word or words which do not apply
2. Mast & Vanes have been painted white & black respectively. \checkmark
3. The station/~~marker~~ ~~constructed~~ on 2.1 ~~1.6~~ m. 19.7 ~~1.7~~ m. dimensions now being: 4 REPILED
- Description of mark: ~~Brass Pin~~ ~~Pin~~ should be explicit, e.g., S/Steel Pillar Plate, Steel plug, Brass plug, Bolt, G.I. Pipe
- Height of mark 0.040 m. ~~above rock/concrete~~ ~~below~~ Mark is NT m. ~~above~~ ~~below~~ G.L.
- Height of Top Vanes to Top Mark/~~Plate~~ 3.5 m. 1.1 m. ~~TOP~~ Diameter of Vanes (vertical) 0.76 m.
- Height of Cairn 1.58 m. Diameter of Cairn 2.4 m. ~~Bolt~~ Name Plate ~~found~~/~~not found~~/placed.
- Length of Mast 3.54 m. (~~approximate~~/~~not~~ omitted)
- A. ~~Copper Nail~~ set in conc/rock has been placed/~~found~~, bearing 91 m. from Mast/Plug/Bolt
- A. ~~G.I. Pipe~~ set in conc/rock has been placed/~~found~~, bearing 146 m. from Mast/Plug/Bolt
- A. ~~Wood Dumpty~~ set in conc/rock has been placed/~~found~~, bearing 4 m. from Mast/Plug/Bolt
- A. set in conc/rock has been placed/~~found~~, bearing 4 m. from Mast/Plug/Bolt
8. Action required:


MAP SHEET SCALE 1:250 000

INSPECTED BY: D. KAIN

AUTHORITY: L.I.C.

DATE: 24 10 94

FIELD BOOK: 580

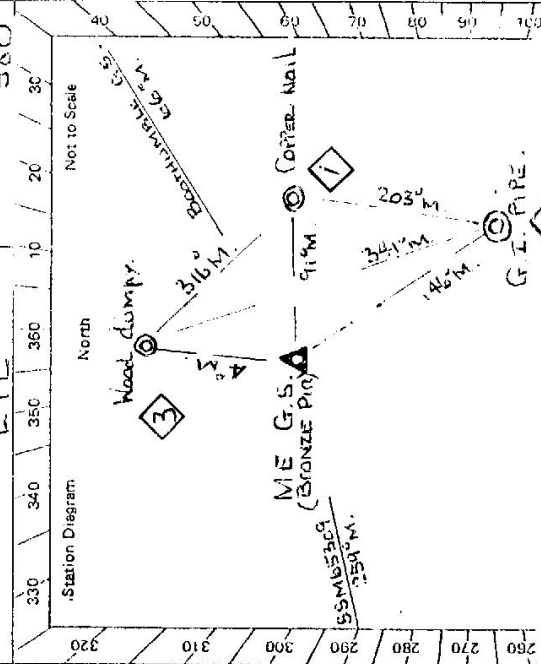

Mark	Direction	Horiz. Distance	Height Difference	Mark	Direction	Horiz. Distance	Height Difference
Boothumple G.S. 0 00 00			above standpt.	Boothumple G.S. 0 00 00			above standpt.
Copper Nail	24 10 15	5.561	0.122 below	G.I. PIPE	135 12 36	5.199	0.077 below
G.I. Pipe	76 54 30	6.095	0.048 below	S.S.M 65309	197 30 50		above standpt.
S.S.M 65309	192 27 33		above standpt.	Trig. Plug	204 11 18	5.566	0.120 below
Wood dumpty	246 33	25.5105	0.717 below	Wood dumpty	247 49 05	7.388	0.593 below
			above standpt.				above standpt.
			below				below
			above standpt.				above standpt.
			below				below

STANDPOINT: G.I. PIPE

STANDPOINT: COPPER NAIL

STANDPOINT: BRONZE PIN

Prepared by: D. Kain

Checked: Noted on U.T.M. Card

Checked:

TS 3038

STATION M E G. S.


Owner's Name: TE 39974
 Address:
 Phone:
 Current Occupant:
 Address:
 Phone:

ACCESS

Access Report of 27/10/1994 was found suitable/unsuitable.

"ON THE ROUND HILL"
 IN ROUND HILL NATURE RESERVE, APPROXIMATELY
 30 KMS. EAST OF MOUNT HOPE ON THE
 EMBALONG WEST ROAD.
 EASY 6 MINUTE WALK TO STATION.

TS 2733-2 D. West, Government Printer

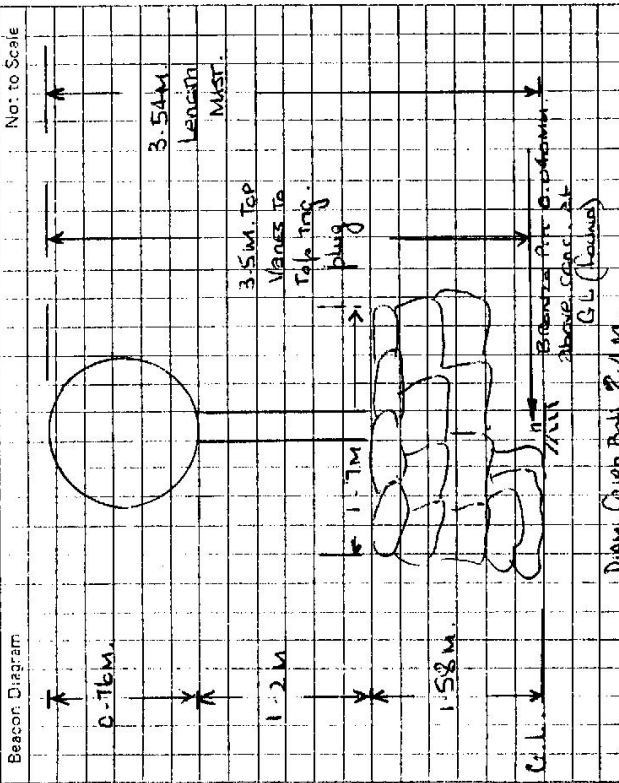

New Trig. Vanes were fitted to Original Pine Trig. Mast
 This section to be completed by officer constructing pillar.

Original station mark found/not found.
 Description of mark:
 Original beacon found/not found.
 Description of beacon:
 Height Top of Vanes to Top Mark.....m.
 Height of mark.....m. above rock/conc.....m. below G.L.
 Diameter of Vanes.....m. Height of Cairn.....m.
 Original Beacon has/not been destroyed by me.

Date	Record of Station