

CENTRAL MAPPING AUTHORITY

GEODETIC SURVEY OF M.S.W.  
 GEODETIC STATION RECONNAISSANCE and MAINTENANCE REPORT

Description:

- Note: Cross out word or words which do not apply
1. Cleared by lances bearing..... Timbered 360° 2-3 days clearing ..... from Trig. Mast  
 Mast & Vanes have been painted white & blank respectively.
  2. The station/pillar was unpiled/not unpiled/constructed on..... 19....., dimensions now being:  
 Description of mark..... should be explicit, e.g., Steel Pillar Plate, Steel plug, Brass plug, Bolt, G.I. Pipe  
 Height of mark.....m. <sup>above</sup> rock/concrete; Mark is.....m. <sup>above</sup> G.L.
  3. Height of Top Vanes to Top Mark/Pillar plate .....m. Diameter of Vanes (vertical).....m.  
 Height of Cairn.....m. Diameter of Cairn.....m. Name Plate found/not found/placed.  
 Length of Mast.....m. (approximate if not unpiled)
  4. A.....set in conc/rock has been placed/found, bearing.....° M from Mast/Plug/Pillar
  5. A.....set in conc/rock has been placed/found, bearing.....° M from Mast/Plug/Pillar
  6. A.....set in conc/rock has been placed/found, bearing.....° M from Mast/Plug/Pillar
  7. A.....set in conc/rock has been placed/found, bearing.....° M from Mast/Plug/Pillar
  8. Action required:..... CHATSBOURX.....  
 1: 25,000

STANDPOINT:

Mark	Direction	Horiz. Distance	Height Difference	Mark	Direction	Horiz. Distance	Height Difference
			above standpt.				above standpt.
			below standpt.				below standpt.
			above standpt.				above standpt.
			below standpt.				below standpt.
			above standpt.				above standpt.
			below standpt.				below standpt.
			above standpt.				above standpt.
			below standpt.				below standpt.

Prepared by: *[Signature]* Checked: *[Signature]*

St 2738-1

Noted on U.T.M. Card

STATION: MEADOW	No.: 3039
MAP SHEET SCALE 1:250 000	FIELD BOOK: 1709
INSPECTED BY: A. Sivertsen	DATE: 2-11-78
AUTHORITY: CMA	

Station Diagram

North

Cairn found 1.5 m

Vanes on ground 0.93 m


A on low hill - inferior site

+

Not to Scale

S: 2733-2 D. West, Government Printer

STATION MEADOW TS 3039

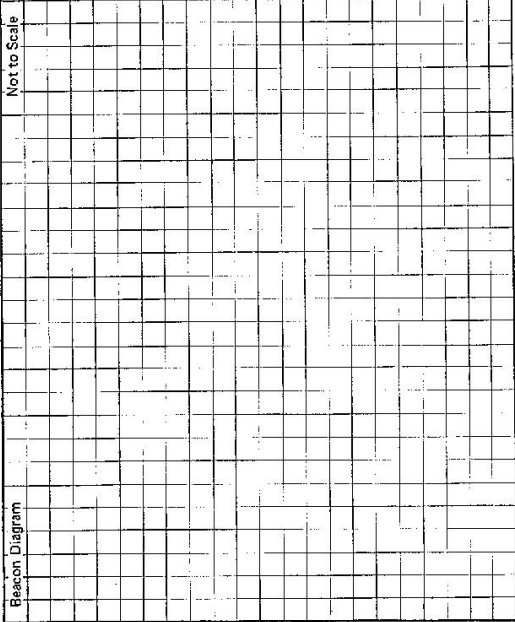

Owner's Name: **Mr. David McWHISTER**  
 Address: **"The Meadows"**  
**GREENWICH PARK**  
 Phone: **(048) 575165**

Current Occupant:  
 Address:  
 Phone:

**ACCESS**

Access Report of **Z. H. / 1818** was found suitable/unsuitable.

- 0.0 Goulburn RD. take Hwy north
- 10.7 Take **TOWRANG / GREENWICH PARK** road to L
- 26.5 Pass road on R
- 32.4 Take gravel road to L. "LONG SWAMP FIRE TRAIL"
- 34.4 Turn L through iron gate
- 34.55 Owners house on L
- 34.65 Through gate on RHS of fowl house, take R fork then follow fence
- 35.1 Through gate & do U-turn
- 35.4 **A MEADOW**

Date	Report of Station

This section to be completed by officer constructing pillar.

Original station mark found/not found.

Description of mark: .....

Original beacon found/not found.

Description of beacon: .....

Height Top of Vanes to Top Mark.....m.

Height of mark.....m. above G.L.

.....m. below

Diameter of Vanes.....m.

Height of Cairn.....m.

Original Beacon has/has not been destroyed by ms.