

CENTRAL MAPPING AUTHORITY

GEODETTIC SURVEY OF N.S.W.

GEODETTIC STATION RECONNAISSANCE and MAINTENANCE REPORT

Description: *Note: Cross out word or words which do not apply*

1. Cleared by lanes bearing..... from Trig, Mast
2. Mast & Vanes have been painted white & black respectively.....
3. The station/pillar was unpainted/not unpainted/constructed on..... 6.7, 1982, dimensions now being:
 - Description of mark..... should be explicit, e.g., S/Steel Pillar Plate, Steel plug, Brass plug, Bolt, G.I. Pipe
 - Height of mark..... above below rock/concrete; Mark is..... above below G.L.
 - Height of Top Vanes to Top Mark/Pillar plate.....m. Diameter of Vanes (vertical) 0.79m.
 - Height of Cairn.....m. Diameter of Cairn.....m. Name Plate found/not found/placed.
 - Length of Mast..... 4.0m. (approximate if not unpainted)
4. A..... set in conc/rock has been placed/found, bearing.....° M from Mast/Plug/Pillar
5. A..... set in conc/rock has been placed/found, bearing.....° M from Mast/Plug/Pillar
6. A..... set in conc/rock has been placed/found, bearing.....° M from Mast/Plug/Pillar
7. A..... set in conc/rock has been placed/found, bearing.....° M from Mast/Plug/Pillar
8. Action required: Mast and vanes need repainted and straightened. Cairn needs partial rebuilding. Small amount of clearing necessary.

STANDPOINT:

Mark	Direction	Horiz. Distance	Height Difference	Mark	Direction	Horiz. Distance	Height Difference
			above standpt				above standpt
			below				below
			above standpt				above standpt
			below				below
Prepared by: G. Coffey Keep 12/7/22. Checked: [Signature] Noted on U.T.M. Card

SI 2733-1

STATION: MEJUM No.: 3047

MAP SHEET SCALE 1:250 000 NARRANDERA

INSPECTED BY: G. KEEP DATE: 6-7-82

AUTHORITY: C. M. A. FIELD BOOK:

Station Diagram

North


Net to Scale

SI 2733-2 D. West, Government Printer

STATION **MEJUM TS 3047**

Beacon Diagram

Mark and vanes in good condition.

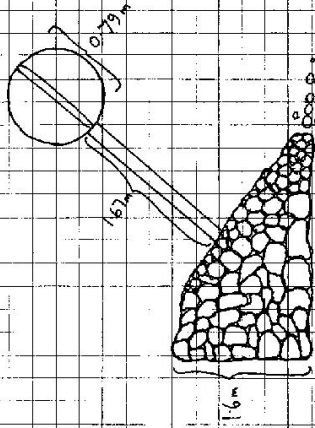

Owner's Name:
 Address:
 Phone:

Current Occupant:
 Address:
 Phone:

ACCESS

Access Report of/18..... was found suitable/unsuitable.
 Access : See Boglony Hills 1:50,000.

This section to be completed by officer constructing pillar.

Original station mark found/not found.

Description of mark:

Original beacon found/not found.

Description of beacon:

Height Top of Vanes to Top Mark.....m.

Height of mark.....m. above G.L.
 below rock/conc.....m.

Diameter of Vanesm. Height of Cairnm.

Original Beacon has/has not been destroyed by me.

Date

Record of Station