

GEODETTIC SURVEY OF N.S.W.

CENTRAL MAPPING AUTHORITY

GEODETTIC STATION RECONNAISSANCE and MAINTENANCE REPORT

STATION: **MELDRLUM** No.: **3049**

MAP SHEET: **Coulburn**
SCALE: 1:250 000

INSPECTED BY: **A. Sivertsen** DATE: **16-10-78**

AUTHORITY: **CMAA** FIELD BOOK: **1709**

Description: *Note: Cross out word or words which do not apply*


1. Cleared by ~~timbered~~ **timbered** **360** from Trig. Mast
 2. Mast & Vanes have been painted white & black respectively.
 3. The station/pillar was unpiled/not unpiled/constructed or 19 dimensions now being:
- Description of mark should be explicit (e.g., S/Steel Pillar Plate, Steel plug, Brass plug, Bolt, G.I. Pipe)
- Height of mark m. ^{above} rock/concrete; Mark is m. ^{above} G.L.
- Height of Top Vanes to Top Mark/Pillar plate m. Diameter of Vanes (vertical) m.
- Height of Cairn m. Diameter of Cairn m. Name Plate found/not found/placed.
- Length of Mast m. (approximate if not unpiled)
4. A. set in conc/rock has been placed/found, bearing ° M from Mast/Plug/Pillar
 5. A. set in conc/rock has been placed/found, bearing ° M from Mast/Plug/Pillar
 6. A. set in conc/rock has been placed/found, bearing ° M from Mast/Plug/Pillar
 7. A. set in conc/rock has been placed/found, bearing ° M from Mast/Plug/Pillar

8. Action required: **KINGS DALE**
1:25 000

STANDPOINT:			
Mark	Direction	Horiz. Distance	Height Difference
			above standpt.
			below standpt.
			above standpt.
			below standpt.
Prepared by: *[Signature]* Checked: *[Signature]* Noted on U.T.M. Card

St 2738-1

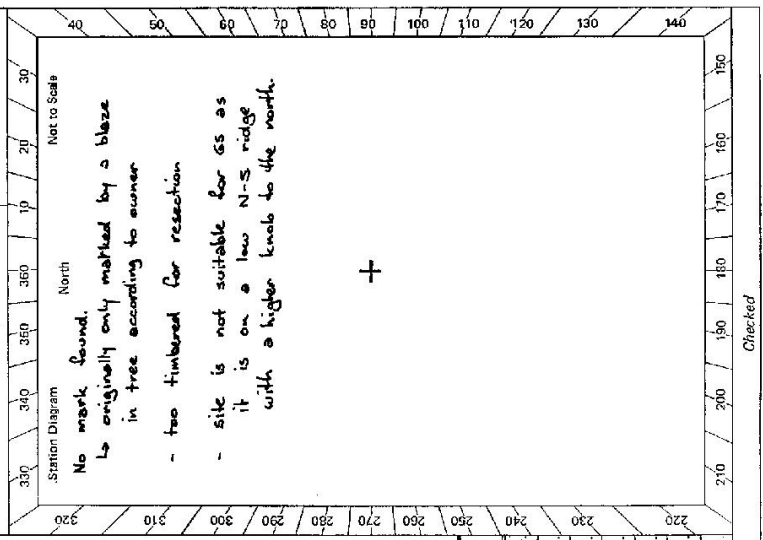


Checked

Sr 2738 - 2 D. West, Government Printer

STATION **MELDRUM TS 3049**

Beacon Diagram Not to Scale

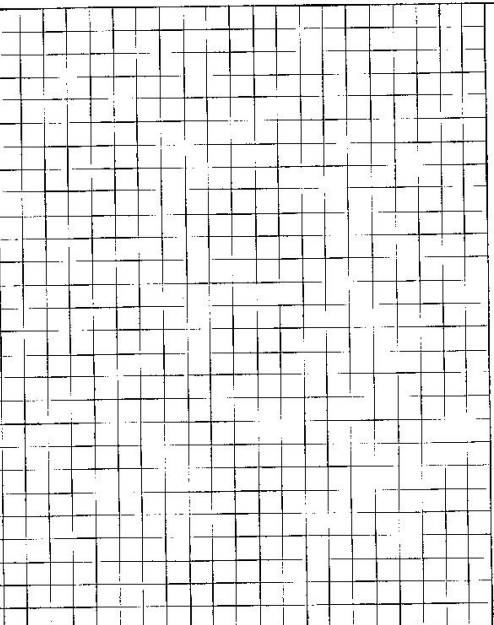

Owner's Name: **KENNETH NOOD**
 Address: **"Norman"**
GOSBURN
 Phone: **21 5738**

Current Occupant
 Address
 Phone

ACCESS

Access Report of **16/10/1978** was found suitable/unsuitable.
 0.0 Gosburn P.O. take Hwy north
 1.8 Turn left following TARALGA signs
 3.6 Turn left up MURRAYS RUN road
 9.1 Turn left along road before rly.
 10.35 Turn right into "Norwood"
 10.4 Through gate in front of wooded of access dem.
 10.6 Creek
 10.7 Take right gate of follow fence
 10.9 Turn left following fence
 11.2 Veer R off fence
 11.6 Gate. Straight ahead
 11.7 Turn L up spur
 12.6 Δ site

This section to be completed by officer constructing pillar.

Original station mark found/not found.

Description of mark:

Original beacon found/not found.

Description of beacon:

Height Top of Vane to Top Markm.

Height of markm above G.L.
 below rock/contcm below

Diameter of Vanem. Height of Cairnm.

Original Beacon has/has not been destroyed by me.

Date	Record of Station