

GEODETIC SURVEY OF N.S.W.

CENTRAL MAPPING AUTHORITY


GEODETIC STATION RECONNAISSANCE and MAINTENANCE REPORT

STATION: **MELLELEA** No.: **3051**

MAP SHEET
SCALE 1:280 000 **CARGELLIGO**

INSPECTED BY: **G. C. HANNA** DATE: **24/5/79**

AUTHORITY: **C. M. A.** FIELD BOOK:

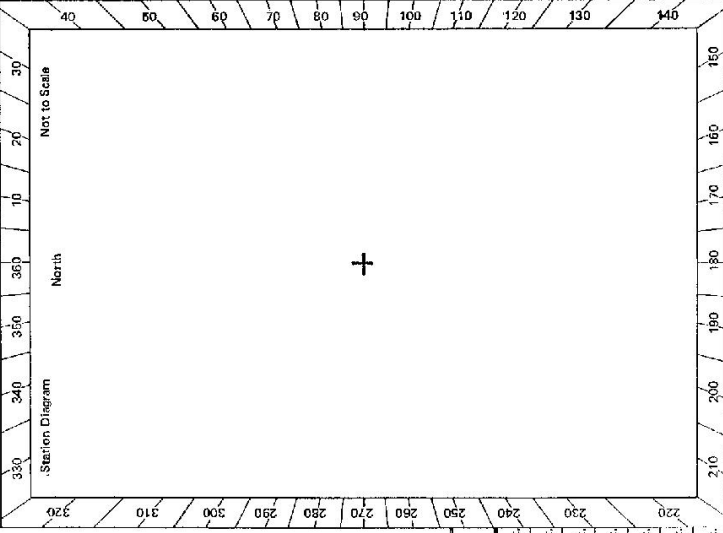

- Description:
 1. Cleared by lanes bearing.....
Note: Cross out word or words which do not apply
 2. Mast & Vanes have been painted white & black respectively.
 3. The station/pillar was unplied/not unplied/constructed on.....
 Description of mark.....
 Height of mark.....m.
 Height of Top Vanes to Top Mark/Pillar plate.....m.
 Height of Cairn.....m.
 Length of Mast.....m.
 4. A.....
 5. A.....
 6. A.....
 7. A.....
 8. Action required:.....

STANDPOINT:			
Mark	Direction	Horiz. Distance	Height Difference
			above standpt.
			below standpt.
			above standpt.
			below standpt.
Prepared by: *G. Hanna* 24/5/79

Checked

S1 2755-1

Noted on U.I.M. Card

