

CENTRAL MAPPING AUTHORITY

GEODETIC SURVEY OF M.S.W.

GEODETIC STATION RECONNAISSANCE and MAINTENANCE REPORT

STATION: MELROSE G.S. No.: 3052

MAP SHEET SCALE 1:250 000

INSPECTED BY: A. COOK. DATE: 5 SEP 1978

AUTHORITY: C.M.A. FIELD BOOK:

Description:
 1. Cleared by lanes bearing.....
 Note: Cross out word or words which do not apply

2. Mast & Vanes have been painted white & black respectively.
 3. The station/pillar was ~~erected~~/not unplied/constructed on.....19....., dimensions now being:

Description of mark.....
 Height of mark.....m. above rock/concrete; Mark is.....m. above G.L.

Height of Top Vanes to Top Mark/Pillar platem. Diameter of Vanes (vertical).....2.74.....m.
 Height of Cairn.....2.20.....m. Diameter of Cairn.....2.5.....m. Name Plate found/not found/placed.

Length of Mast.....4.65.....m. (approximate if not unplied)


4. A.....set in conc/rock has been placed/found, bearing.....° M from Mast/Plug/Pillar

5. A.....set in conc/rock has been placed/found, bearing.....° M from Mast/Plug/Pillar

6. A.....set in conc/rock has been placed/found, bearing.....° M from Mast/Plug/Pillar

7. A.....set in conc/rock has been placed/found, bearing.....° M from Mast/Plug/Pillar

8. Action required: SPAIN Felling about 2 Days clearing needed. Not suitable for pillar.

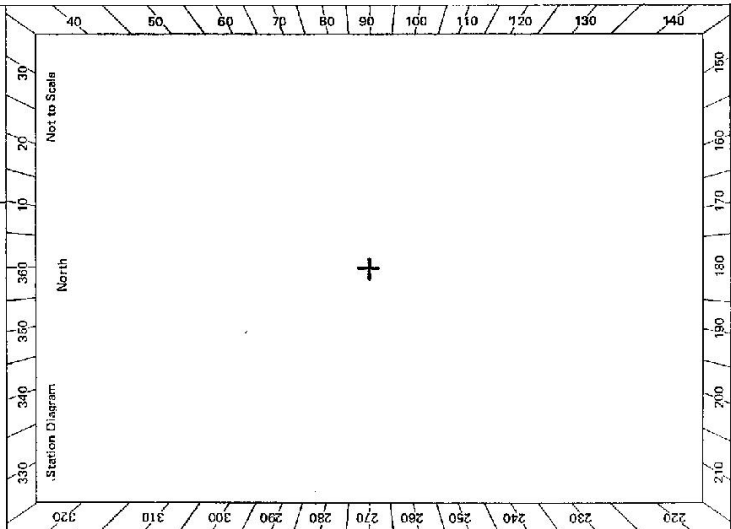

STANDPOINT:			
Mark	Direction	Horiz. Distance	Height Difference
			above standpt.
			below standpt.
			above standpt.
			below standpt.

Prepared by: R. COOK

Checked:

Noted on U.T.M. Card

Checked

St. 2738 - 2 D. West, Government Printer

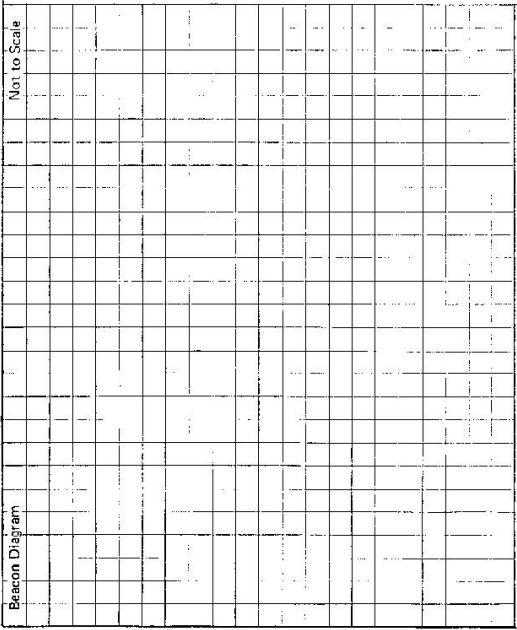STATION MELROSE G.S. TS. 3052	Owner's Name: Address: Phone: Current Occupant: Address: Phone: Access Report of SEPT 178 ACCESS was found suitable/unusable. 15 minute walk from base of Hill. Access found on the Boona 1:50,000 sheet.
Beacon Diagram 	This section to be completed by officer constructing pillar. Original station mark found/not found. Description of mark: Original beacon found/not found. Description of beacon: Height Top of Vanes to Top Mark m. Height of mark m. above G.L. below Diameter of Vanes m. Height of Cairn m. Original Beacon has/has not been destroyed by me.
Date SEPT. 178	Record of Station STATION VISITED in connection with field completion