

TS
STATION 3063 (MEREWETHER TS.)



Current Occupant.....

Address.....

Owners Name.....

Address.....

1968
Access Follow SCENIC HIGHWAY (OFF PACIFIC HIGHWAY) FOR 1.9 km TO CHARLOTTE STREET, MEREWETHER.

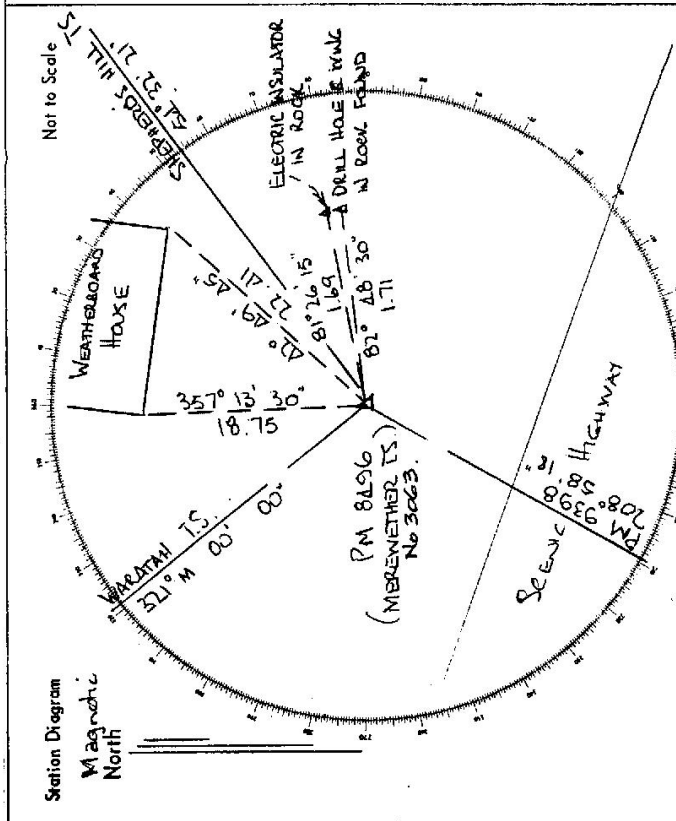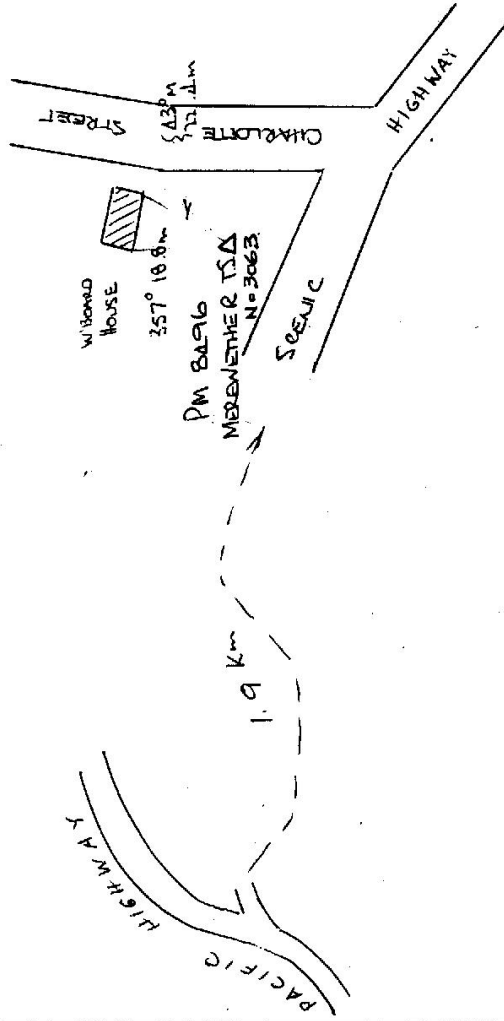

List of Observed Directions:- refer WAC 78136

Standpoint: PM 8496

Station	Direction	Station	Direction
PM 2398	110 04 14		
WEATHERBOARDS HILL (P)	321 05 56		
SHEPHERDS HILL (P)	275 38 17		