

CENTRAL MAPPING AUTHORITY

GEODETIC SURVEY OF N.S.W.

GEODETIC STATION RECONNAISSANCE and MAINTENANCE REPORT


STATION: **MEROOL** No.: **TS 3071**

MAP SHEET SCALE 1:250 000 **NARRANDERA**

INSPECTED BY: **P. Naylor** DATE: **14.7.77**

AUTHORITY: **C.M.A.** FIELD BOOK:

- Description:
- Cleared by lanes bearing..... Note: *Cross out word or words which do not apply*..... from Trig. Mast
 - Mast & Vanes have been painted white & black respectively.
 - The station/pillar was unpiled/~~re-erected~~/~~corrected~~ on..... **14.7.1977**....., dimensions now being: **3.03** ^{above} ~~below~~..... should be explicit, e.g., S/Steel Pillar Plate, Steel plug, Brass plug, Bolt, G.I. Pipe
Description of mark.....
Height of mark.....m. ^{above} ~~below~~ rock/concrete; Mark is.....m. ^{above} ~~below~~ G.L.
Height of Top Vanes to Top Mark/Pillar plate.....m. Diameter of Vanes (vertical).....m.
Height of Cairn.....m. Diameter of Cairn.....m. Name Plate found/not found/placed.
Length of Mast.....m. (approximate if not unpiled)
 - A.....set in conc/rock has been placed/found, bearing.....° M from Mast/Plug/Pillar
 - A.....set in conc/rock has been placed/found, bearing.....° M from Mast/Plug/Pillar
 - A.....set in conc/rock has been placed/found, bearing.....° M from Mast/Plug/Pillar
 - A.....set in conc/rock has been placed/found, bearing.....° M from Mast/Plug/Pillar
 - Action required:.....
STATION IS SUITABLE FOR CONV. PILLAR.

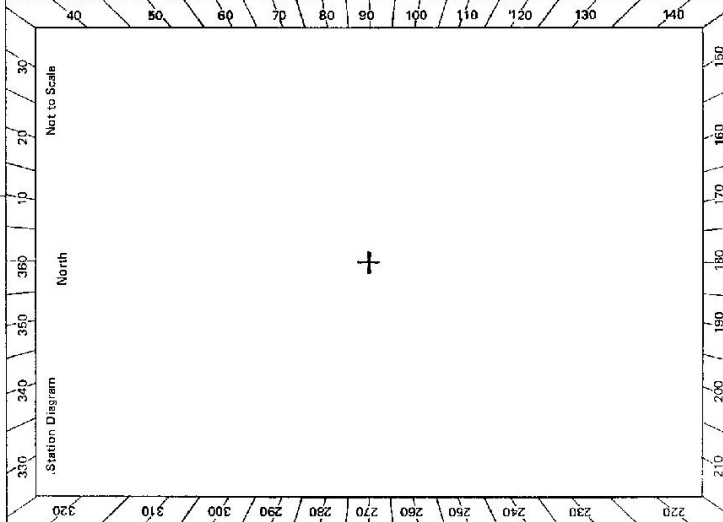

STANDPOINT:

Mark	Direction	Horiz. Distance	Height Difference	Mark	Direction	Horiz. Distance	Height Difference
			above below standpt.				above below standpt.
			above below standpt.				above below standpt.
Prepared by: *P. Naylor* Checked: *P.P.B.* Noted on U.T.M. Card

63

STATION Mesool TS 3071

Owner's Name: Cheryl Lind / TIC
 Address: Reserve
 Phone:
 Current Occupant: K O'Callaghan
 Address: Wigg Vale
 Phone:

ACCESS

Access Report of 14.7.1971 was found suitable/unsuitable.
NACAMIDEA
1:250,000 MAP REFERENCE
391 / 789

Owner's Name:
 Address:
 Phone:
 Current Occupant:
 Address:
 Phone:

Record of Station

Not to Scale

This section to be completed by officer constructing pillar.
 Original station mark found/not found:
 Description of mark:
 Original beacon found/not found:
 Description of beacon:
 Height Top of Vanes to Top Mark:m.
 Height of mark:m. above rock/cont. below G.L.
 Diameter of Vanes:m. Height of Cairn:m.
 Original Beacon has/has not been destroyed by me.

Sr 2738-2 D. Wear, Government Printer

CS 2793-2 D. West, Government Printer

<p>Beacon Diagram</p> <p>Not to Scale</p> <p>This section to be completed by officer constructing pillar.</p> <p>Original station mark found/not found.</p> <p>Description of mark:</p> <p>Original beacon found/not found.</p> <p>Description of beacon:</p> <p>Height Top of Vanes to Top Mark.....m.</p> <p>Height of mark.....m. above rock/conc.....m. below above G.L.</p> <p>Diameter of Vanes.....m. Height of Cairn.....m.</p> <p>Original Beacon has/has not been destroyed by me.</p>	
--	--

<p>3-12-99</p> <p>7-90</p> <p>8.15</p>	<p>STATION IS IN GOOD CONDITION CUMUL FD = GI PAS FD.</p> <p>GOOD FOR GPS</p> <p>OPEN TOP HILL WITH TREES AROUND SIDGES</p>	<p>3071 Merool</p> <p>At Tabbia about 30 km northwest of Griffith (Griffith / Goolgowi Rd)</p> <p>Take road to right just south of silos.</p> <p>Cross railway line</p> <p>Straight ahead to grid off main road (cross O'Callaghans Rd)</p> <p>Over grid then right (sign Okydoky RM 853)</p> <p>Left along road</p> <p>Right through gate to house</p> <p>Pass house</p> <p>Pass in front of machinery shed and through cattle yards (3 gates)</p> <p>Then left across small paddock and through wire gate into lane way (5.55)</p> <p>Wire gate</p> <p>Right to wire gate in fence corner (just before track turns left)</p> <p>Through two wire gates into hill paddock then left following track going slightly away from fence</p> <p>Take track to right (large Kurrajong tree over fence on left)</p> <p>Pass tracks on left at 7.15 & 7.35</p> <p>Take right track</p> <p>Merool Trig</p>
--	---	---

STATION **MEROOL GS 3071**

Owner's Name: **TR**

Address:

Phone:

Current Occupant: **H O'CALLAGAN**

Address: **OKYDOKY RM 853**

Phone: **69 688242**

Access Report of:/19..... was found suitable/unsuitable

ACCESS

INSPECTED BY: **G. FORD** DATE: **3-12-99**

Date

Record of Station