

CENTRAL MAPPING AUTHORITY

GEODETIC SURVEY OF N.S.W.

GEODETIC STATION RECONNAISSANCE and MAINTENANCE REPORT

Description:

Note: Cross out word or words which do not apply

1. Cleared by lances bearing..... $35^{\circ} 30'$ $75^{\circ} 145'$ $195^{\circ} 297'$ from Trig. Mast
2. Mast & Vanes have been painted white & black respectively.
3. The station/~~pillar~~ ~~was unplaced~~ /not unplaced/~~concrete~~ on..... $12^{\circ} 19' 31''$ $19^{\circ} 31''$, dimensions now being:
 Description of mark..... should be explicit; e.g., S/Steel Pillar Plate, Steel plug, Brass plug, Bolt, G.I. Pipe
 Height of mark..... 0.5 m. ^{above} rock/concrete; Mark is..... 0.5 m. ^{above} G.L.
 Height of Top Vanes to Top Mark/Pillar plate..... m. Diameter of Vanes (vertical)..... m.
 Height of Cairn..... 0.5 m. Diameter of Cairn..... m. Name Plate found/not found/placed.
 Length of Mast..... m. (approximate if not unplaced)
4. A..... set in conc./rock has been placed/found, bearing..... 0° M from Mast/Plug/Pillar
5. A..... set in conc./rock has been placed/found, bearing..... 0° M from Mast/Plug/Pillar
6. A..... set in conc./rock has been placed/found, bearing..... 0° M from Mast/Plug/Pillar
7. A..... set in conc./rock has been placed/found, bearing..... 0° M from Mast/Plug/Pillar
8. Action required:..... *Station is a little below the level of the top of the pillar...*


STANDPOINT:

Mark	Direction	Horiz. Distance	Height Difference	Mark	Direction	Horiz. Distance	Height Difference
			above standpt				above standpt
			below				below
			above standpt				above standpt
			below				below
Prepared by: *Mark...* Checked: *Mark...*

S. 2733-1

Noted on U.T.M. Card

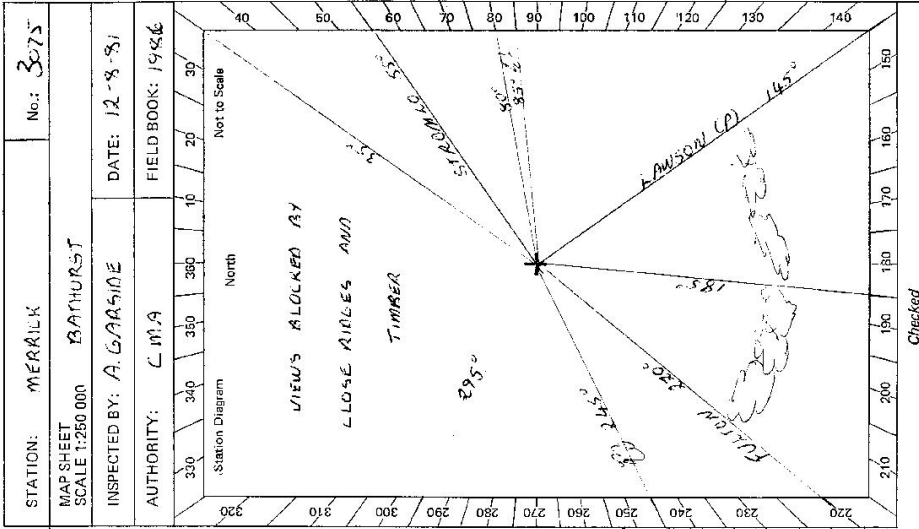

Checked

STATION: MERRILLK No.: 3075

MAP SHEET SCALE 1:250 000 BATHURST

INSPECTED BY: A. GARLAND DATE: 12-8-81

AUTHORITY: C.M.A. FIELD BOOK: 1946

STATION **MERRICK TS 3075**


Owner's Name: *E. COLLIER, MARRAMERE*
 Address: *MARRAMERE, 14 ABRAHAM COOPER*
6 MARRAMERE RD, MARRAMERE
 Phone: *06 475 57 49 43*
 Current Occupant:
 Address:
 Phone:

ACCESS **12-8-1981**

Access Report of *21/8/1981* ~~was found to be not suitable~~

- Km
- 0-0
- 1-25
- 3-35
- 5-75
- 6-3
- 6-65

Feature
ACKLEY PO FINE ROAD TO 'BURRADA 35'
POSS ROAD ON LEFT 'DIBBY VIA CHANNEL 32'
'OREGON VIA BLACK SPRINGS 50'
MALBOX AND GRID ON LEFT 'BURMAMAGUC'
PASS GATE ON RIGHT POSSIBLE DRIVE TO ACCESS. TWO WEL AT TIME
EP REECE
STOP VEHICLE AT CREEK (WIRE ACROSS GULLY) TO MIDDIE WALK UP
HILL ON RIGHT.

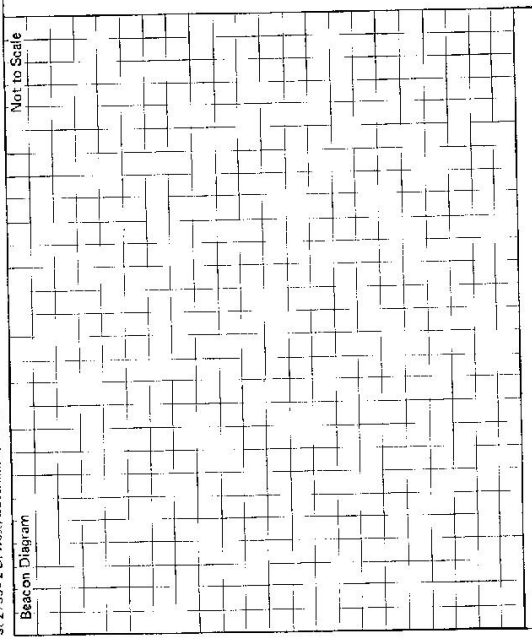

This section to be completed by officer constructing pillar.

Original station mark found/not found.
 Description of mark
 Original beacon found/not found.
 Description of beacon:
 Height Top of Vanes to Top Markm.
 above below
 rock/compm. above G.L.
 below below
 Diameter of Vanesm. Height of Cairnm.
 Original Beacon has/has not been destroyed by ma.

Date	Record of Station