

CENTRAL MAPPING AUTHORITY

GEODETIC SURVEY OF N.S.W.

GEODETIC STATION RECONNAISSANCE and MAINTENANCE REPORT

STATION: **MICKMILL** No.: **3092**

Description: *Note: Cross out word or words which do not apply*

MAP SHEET SCALE 1:250 000 **NARROMINE**

1. Cleared by lanes bearing..... from Trig. Mast

INSPECTED BY: **R. COOK** DATE: **SEPT 1978**

2. Mast & Vanes have been painted white & black respectively.

AUTHORITY: **C.M.A.** FIELD BOOK:

3. The station/pillar ~~was~~ ~~erected~~/not unpiled/constructed on.....19....., dimensions now being:

Description of mark..... should be explicit, e.g., S/Steel Pillar Plate, Steel plug, Brass plug, Bolt, G.I. Pipe

Height of mark.....m. ^{above} rock/concrete; Mark is.....m. ^{above} G.L.

Height of Top Vanes to Top Mark/Pillar plate.....m. Diameter of Vanes (vertical).....m.

Height of Cairn.....m. Diameter of Cairn.....m. Name Plate found/not found/placed.

Length of Mast.....m. (approximate if not unpiled)

4. A.....set in conc/rock has been placed/found, bearing.....° M from Mast/Plug/Pillar

5. A.....set in conc/rock has been placed/found, bearing.....° M from Mast/Plug/Pillar

6. A.....set in conc/rock has been placed/found, bearing.....° M from Mast/Plug/Pillar

7. A.....set in conc/rock has been placed/found, bearing.....° M from Mast/Plug/Pillar

8. Action required: **SPAN falling off Ant. NO MAST & RINGS. Examination...clearing needed;**

STANDPOINT: **Not suitable for killer.**


Mark	Direction	Horiz. Distance	Height Difference	Mark	Direction	Horiz. Distance	Height Difference
			above standpt.				above standpt.
			below				below
			above standpt.				above standpt.
			below				below
Prepared by: **R. COOK**

Checked: *Not on U.T.M. Card*

Checked

ST 2733-1

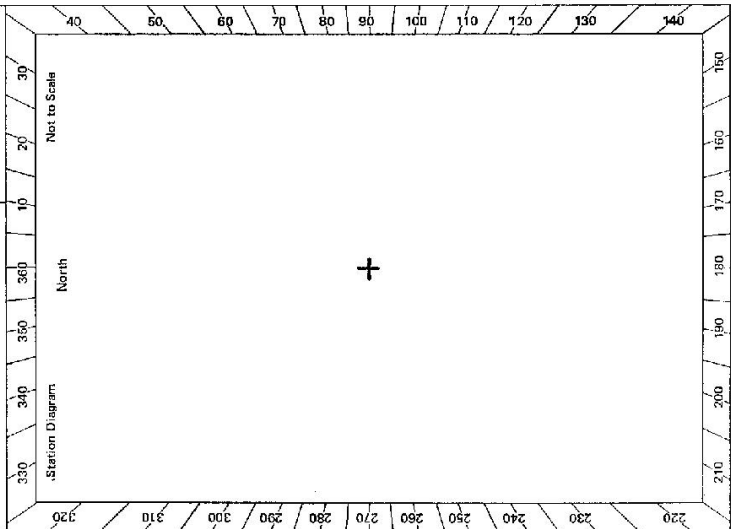

St 2733--2 D. West, Government Printer

Beacon Diagram	Not to Scale

This section to be completed by officer constructing pillar.

Original station mark found/not found.

Description of mark:

Original beacon found/not found.

Description of beacon:

Height Top of Vanes to Top Mark m.

Height of mark m. above rock/cont. below G.L.

Diameter of Vanes m.

Original Beacon has/has not been destroyed by me. Height of Cairn m.

STATION MICIKIMILL G.S. TS 3092

Owner's Name:

Address:

Phone:

Current Occupant:

Address:

Phone:

ACCESS

Access Report of Sept 1978 was found suitable/unsuitable.
Drive to (access.) Found on the Boona 1:50,000 sheet.

Date	Record of Station
SEPT 1978	STATION VISITED IN Separation Av. H. Field Completion