

GEODETTIC SURVEY OF NSW

CENTRAL MAPPING AUTHORITY

GEODETTIC STATION RECONNAISSANCE and MAINTENANCE REPORT

Description:

Note: Cross out word or words which do not apply

1. Cleared by lanes bearing..... from Trig, Mast
2. Mast & Vanes have been painted white & black respectively.
3. The station/pillar was unpiled/hot unpiled/constructed on.....19....., dimensions now being:
Description of mark.....should be explicit, e.g., S/Steel Pillar Plate, Steel plug, Brass plug, Bolt, G.I. Pipe
Height of mark.....m. ^{above} _{below} rock/concrete: Mark is.....m. ^{above} _{below} G.L.
Height of Top Vanes to Top Mark/Pillar platem. Diameter of Vanes (vertical).....m.
Height of Cairn.....m. Diameter of Cairn.....m. Name Plate found/not found/placed.
Length of Mast.....m. (approximate if not unpiled)
4. A.....set in conc/rock has been placed/found, bearing.....°M from Mast/Plug/Pillar
5. A.....set in conc/rock has been placed/found, bearing.....°M from Mast/Plug/Pillar
6. A.....set in conc/rock has been placed/found, bearing.....°M from Mast/Plug/Pillar
7. A.....set in conc/rock has been placed/found, bearing.....°M from Mast/Plug/Pillar
8. Action required:.....

STANDPOINT:

Mark	Direction	Horiz. Distance	Height Difference	Mark	Direction	Horiz. Distance	Height Difference
			above standpt.				above standpt.
			below				below
			above standpt.				above standpt.
			below				below
Prepared by: *Keith Haskell* Oct 73 Checked: *Keith Haskell*

Noted on U.T.M. Card

ST 2738-1


STATION: MIDDLEFIELD No.: 3095

MAP SHEET SCALE 1:250,000 NARRONWEE

INSPECTED BY: K. HADSON DATE: August 1977

AUTHORITY: C.M.A. FIELD BOOK:

<p>Owner's Name:</p> <p>Address:</p> <p>Phone:</p> <p>August 1978 Access Report of...../19.....was found suitable/unsuitable.</p>	<p style="text-align: center;">STATION MIDDLEFIELD TS 3095</p> <p>Current Occupant:</p> <p>Address:</p> <p>Phone:</p> <p>See Datasheet TS 3095</p> <p>From Tullamore proceed North 17.5 km towards Tethenham. Turn left off main road and follow track for 3.0 km. On right is locked gate. (Whereabouts of key is not known) (Fence can be let down 50 metres further along track) Follow track through gate for 1 km. Leave vehicle and head west up ridge to highest point. At Trig. (10 minute walk)</p> <p>[Note. Track could be cleared up ridge to Trig]</p>
--	--

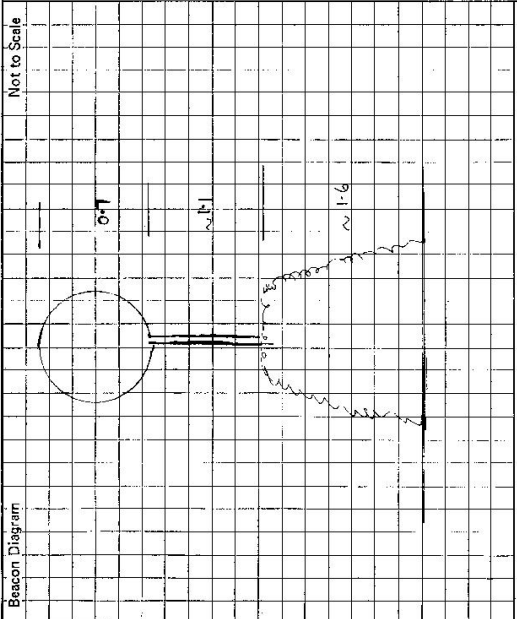

This section to be completed by officer constructing pillar.

Original station mark found/not found.

Description of mark:

Original beacon found/not found.

Description of beacon:

Height Top of Vanes to Top Mark.....m.

Height of mark.....m. above G.L. below

Diameter of Vanesm. Height of Cairnm.

Original Beacon has/has not been destroyed by me.

Date	Record of Station
<p>Aug 1978</p>	<p>Visited 360° clearing required. Cairn, Pole and disc found in good order. Repairs. Painting.</p>