

CENTRAL MAPPING AUTHORITY
Department of Lands

Trigonometrical Survey of N.S.W.

RECONNAISSANCE and MAINTENANCE REPORT

This Trig. Station has been:-

Note: Cross out word or words which do not apply

1. Completely cleared to permit 360° vision to surrounding Trigs. 3/3/77 *R. Cook*
2. Cleared by lanes bearing *W. or E.* from Trig. Mast
3. Trig. Mast & Vanes ~~base~~ *base* painted ~~white~~ *black* respectively.
4. The Trig. was ~~unpiled~~ / not unpiled, dimensions now being: Station Mark ~~Revised~~ *not found*

Description of mark..... should be explicit, e.g. Steel plug, Brass plug, Bolt, G.I. Pipe
 Height of mark..... m ^{above} / _{below} rock/concrete m ^{above} / _{below} G.L.
 Height of Top Vanes to Top Mark... 3.6... m. Diameter of Vanes (vertical)... 2... m.
 Height of Cairn... 1.9... m. Diameter of Cairn... 2.4... m.

5. A..... set in conc/rock has been placed..... m. bearing.....°M from Trig. Mast
6. A..... set in conc/soil has been placed..... m. bearing.....°M from Trig. Mast
7. A..... set in conc/soil has been placed..... m. bearing.....°M from Trig. Mast
8. A..... set in conc/rock has been placed..... m. bearing.....°M from Trig. Mast
9. Connection..... to..... m. bearing.....°M
10. Connection..... to..... m. bearing.....°M
11. Connection..... to..... m. bearing.....°M
12. Connection..... to..... m. bearing.....°M
13. Diff. Ht. is..... m. ^{above} / _{below}
14. Diff. Ht. is..... m. ^{above} / _{below}
15. Diff. Ht. is..... m. ^{above} / _{below}
16. Diff. Ht. is..... m. ^{above} / _{below}

Prepared by: *R. Cook* Checked: *I.W. Robins* (1977) Noted on U.T.M. Card

STATION MILBURN TS 3103


Co: BATHURST | Ph: MILBURN

Map Sheet: COWRA 8630 II 4 III 574 | No: 8630-S

Inspected by: RODNEY COOK | Date: 3/3/77

Authority: | Field Book: COWRA
Not to Scale

Beacon Diagram

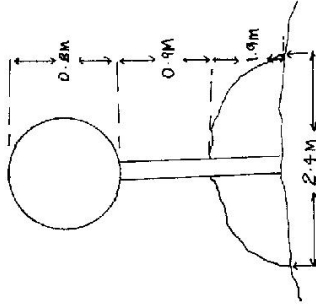

Date Record of Station

Checked

