




STATION MILLI ELD (P) TS 3105

Owners Name.....  
Current Occupant.....

Address.....  
Address.....

- Access 22-9-1976  
Van. FEATHER  
b.o. TURN THE VIEW RD + WOLLUMBI RD ON MULLFIELD.  
0-75 "WOLLUMBI BRIDGE" BRIDGE  
1-00 TURN LEFT AT SIGN "CORROBORO STATE FOREST" + "HARRIS RD"  
1-3 STRAIGHT AHEAD ON MAIN TRACK  
2-75 GRID.  
2-85 "STRAIGHT AHEAD. "DAN" CORROBORO"  
3-05 "  
3-55 GRID  
5-35 GRID  
6-15 TURN HARD RIGHT AT GRID - SIGN "NORTH ROAD"  
6-4 LOCKEY GATE - (LANDO KEY 74332)  
7-7 SIGN "LUMBUS ROAD"  
9-15 MILLIE DROO GATE.  
8-45 \* TURN LEFT OFF TRACK AT TOP OF RISE - SMALL CUTTING.  
8-5 TRIA.

\* Conventional drive vehicle to here in all weather conditions.

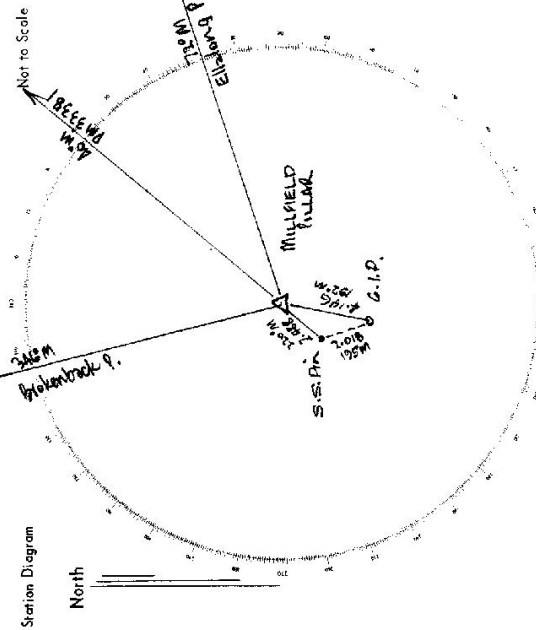

List of Observed Directions:-  
Standpoint: Ellar Pkyle      Standpoint: S.S. Pin.

Station	Direction	Station	Direction
Prokombe P.	0° 00' 00"	Prokombe P.	0° 00' 00"
Ellidong P.	54° 35' 34.85"	Ellidong P.	47° 56' 09.5"
G.I.P.	86° 41' 43.07"	G.I.P.	86° 41' 37"
S.S. Pin	207° 20' 16.5"	G.I.P.	181° 37' 43.5"
	227° 56' 18.0"		

