


STATION MINNIVILLE (PTS) 3124


Owners Name.....
 Current Occupant.....
 Address.....
 Address.....

Access UBQ MAP 32A E 1 14-8-1975
 CONVENTIONAL VEHICLE ACCESS

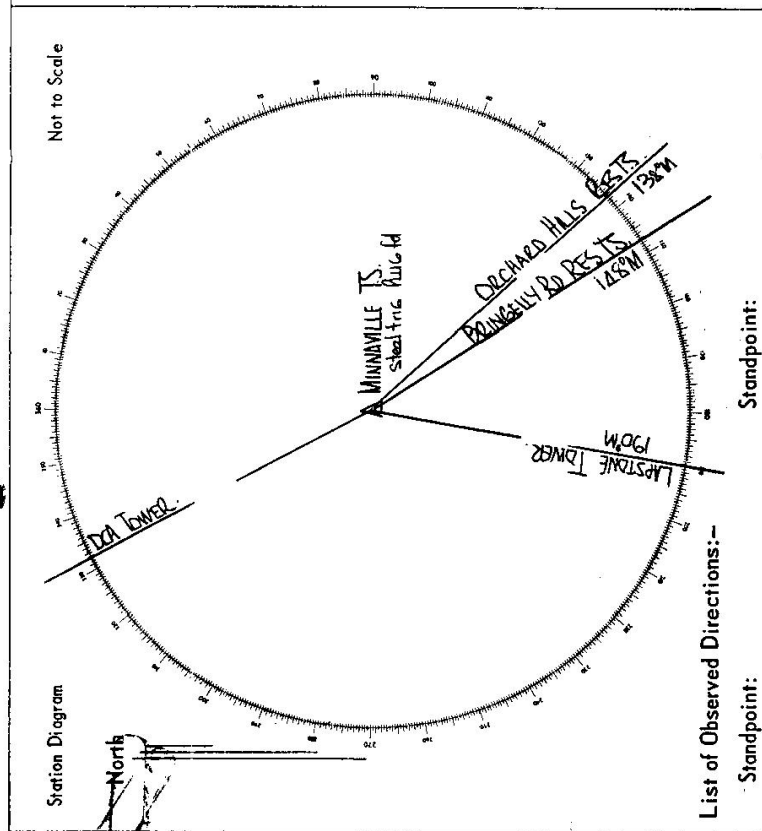

List of Observed Directions:-

Standpoint:		Standpoint:	
Station	Direction	Station	Direction
ORCHARD HILLS RES TS	59° 57' 60"		
BRINGALLY BA RES TS	8° 37' 33.3"		
LAPSTONE TOWER	48° 47' 07.9"		
DCA TOWER	190° 31' 03.6"		

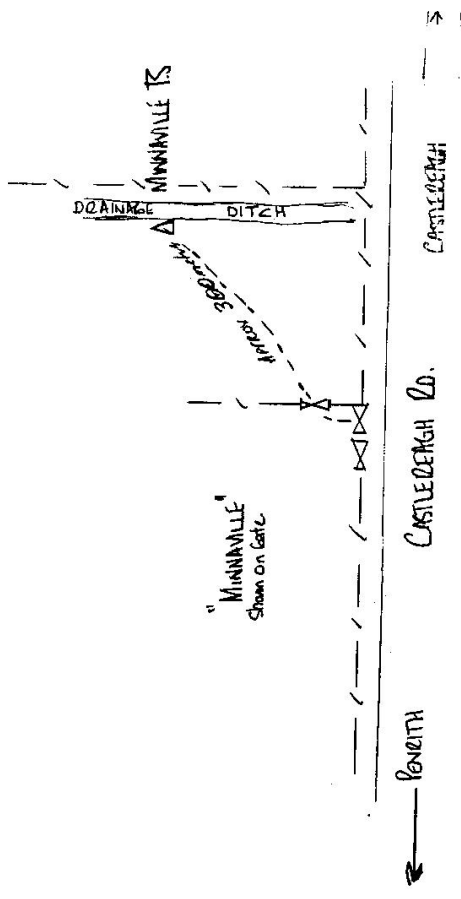

75-10-3

Department of Lands

Integrating Survey of N.S.W.

RECONNAISSANCE and MAINTENANCE REPORT

This Trig. Station has been:

Note: Cross out word or words which do not apply

- 1. Completely cleared to permit 360° vision to surrounding Trigs.
- 2. ~~Cleared by~~ ~~lines-bearing~~ from Trig. Mast
- 3. Trig. Mast & Vanes have been painted white & black respectively.
- 4. The Trig. was unpiled/not unpiled, dimensions now being:

Description of mark: **Concrete Pillar** should be explicit, e.g. Steel plug, Brass plug, Bolt, Concrete Pillar

Height of mark: $\begin{matrix} \text{above} \\ \text{below} \end{matrix}$ m rock/concrete $\begin{matrix} 1.38 \\ \text{below} \end{matrix}$ m above G.L.

Height of Top Vanes to Top Mark/Top pillar plate $\begin{matrix} 1.44 \\ \text{below} \end{matrix}$ m Diameter of Vanes (vertical) $\begin{matrix} 0.60 \\ \text{below} \end{matrix}$ m.

Height of Cairn.....m. Diameter of Cairn.....m.

Length of Mast.....m. (approximate if not unpiled)

5. ~~A. Old trig. Plug~~ set in conc./rock has been placed/fd $\begin{matrix} 5.938 \\ \text{below} \end{matrix}$ m. bearing $\begin{matrix} 91 \\ \text{below} \end{matrix}$ °M from Trig. Mast/pillar

6. ~~A. SSM 23801~~ set in conc./soil has been placed/fd $\begin{matrix} 3.205 \\ \text{below} \end{matrix}$ m. bearing $\begin{matrix} 144 \\ \text{below} \end{matrix}$ °M from Trig. Mast/pillar

7. A.....set in conc./soil has been placed/fd.....m. bearing.....°M from Trig. Mast/pillar

8. A.....set in conc./rock has been placed/fd.....m. bearing.....°M from Trig. Mast/pillar

9. Connection Trig. Plug. to ~~SSM 23801~~: $\begin{matrix} 4.783 \\ \text{below} \end{matrix}$ m. bearing $\begin{matrix} 230 \\ \text{below} \end{matrix}$ °M

10. Connection.....to.....m. bearing.....°M

11. Connection.....to.....m. bearing.....°M

12. Connection.....to.....m. bearing.....°M

13. Diff. Ht. ~~Pillar Plate~~ is $\begin{matrix} 1.81 \\ \text{below} \end{matrix}$ m. ~~above~~ ~~Old trig. Plug~~


14. Diff. Ht. ~~Pillar Plate~~ is $\begin{matrix} 1.73 \\ \text{below} \end{matrix}$ m. ~~above~~ ~~SSM 23801~~

15. Diff. Ht. is.....m. ~~above~~

16. Diff. Ht. is.....m. ~~above~~

Prepared by: *F.F. Sullivan* Checked:

STATION **MINNIVILLE (P)** 3124
 Co: **Campbell** Ph: **CASTLEREACH**
 Map Sheet: **CASTLEREACH 1:10 000** No: **6467**
 Inspected by: **F.F. Sullivan** Date: **18.7.1977**
 Authority: **LANDS DEPARTMENT** Field Book: **PDP 574**
 Beacon Diagram Not to Scale $\frac{1}{250}$

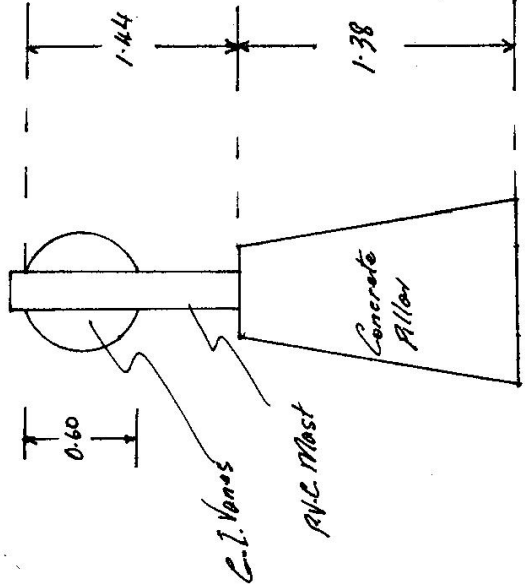

Date	Record of Station
11.77	Pillar Placed
18.7.77	Pillar connected to Trig Plug
11.77	SSM 23801 placed.

STATION T.S. 3124 MINNAVILLE (P)


Current Occupant.....

Address.....


Owners Name.....

Address.....

Access 18-7-1977

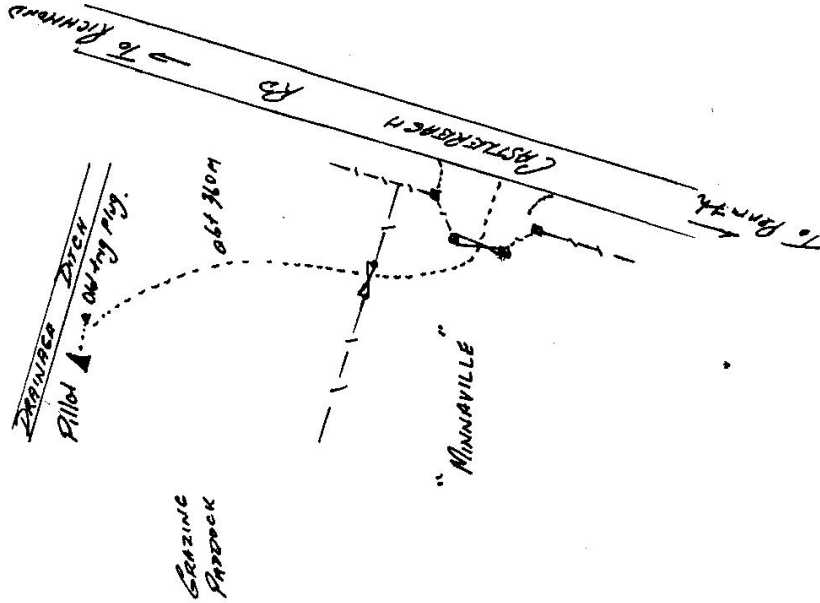

Not to Scale

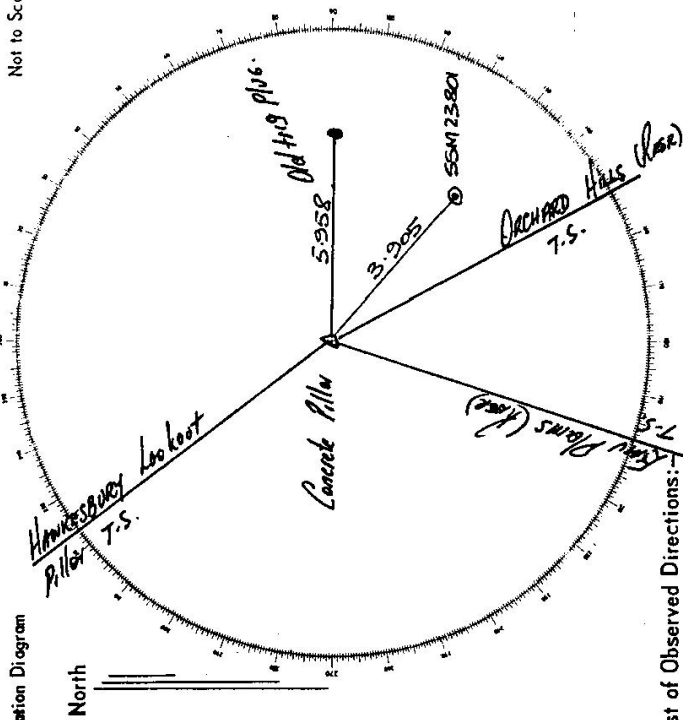


List of Observed Directions:

Standpoint: Pillar

Station	Direction	Station	Direction
HAWKESBURY Lookout Pillar	0 00		
ORCHARD HILLS Peak	181 28 25		
NEW PLAINS Peak	235 13 48		
Old Hdg. pluc.	136 10 12		
SSM 23801	182 32 57		

SA 2733-2 D. West, Government Printer

Beacon Diagram Not to Scale

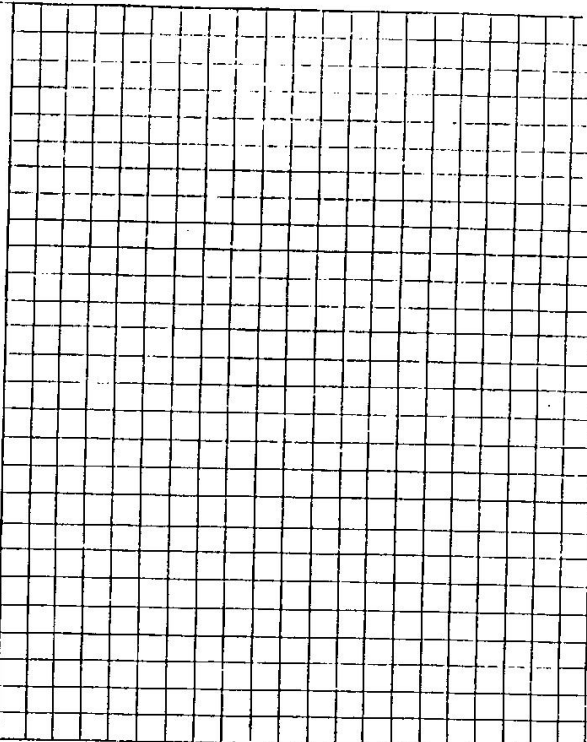

STATION MINNAYILLE (P) 3124

Owner's Name: PENRITH LAKES
 Address: DEVELOPMENT CORPORATION
UPPER CASTLEREAGH
 Phone: 02 4739 0044

Current Occupant: _____
 Address: _____
 Phone: _____

INSPECTED BY: G. FORD DATE: 26-7-00

3124 Minnaville (P) SPRINGWOOD 1:25000

- 0.0 Intersection of Springwood Road (Hawkesbury Road)
- 7.6 And Castlereagh Road Head towards Penrith
- 10.5 Pass Castlereagh Hall on right
- Pillar abt 200 metres across paddock

This section to be completed by officer constructing pillar.

Original station mark found/not found:

Description of mark:

Original beacon found/not found:

Description of beacon:

Height Top of Vanes to Top Mark:m.

Height of mark:m. above rock/conem. above G.L. below

Diameter of Vanesm. Height of Cairnm.

Original Beacon has/has not been destroyed by me.

Prepared by: G Ford 27/7/00

Date	Record of Station