

75-19

Department of Lands

Integrated Survey of N.S.W.

RECONNAISSANCE and MAINTENANCE REPORT 3129

STATION MINTO (P) TS 3129

Co: Ph:

Map Sheet: No:


Inspected by: Date:

Authority: Field Book:

Beacon Diagram Not to Scale

Note: Cross out word or words which do not apply

1. Completely cleared to permit 360° vision to surrounding Trigs.
2. Cleared by lanes bearing from Trig. Mast

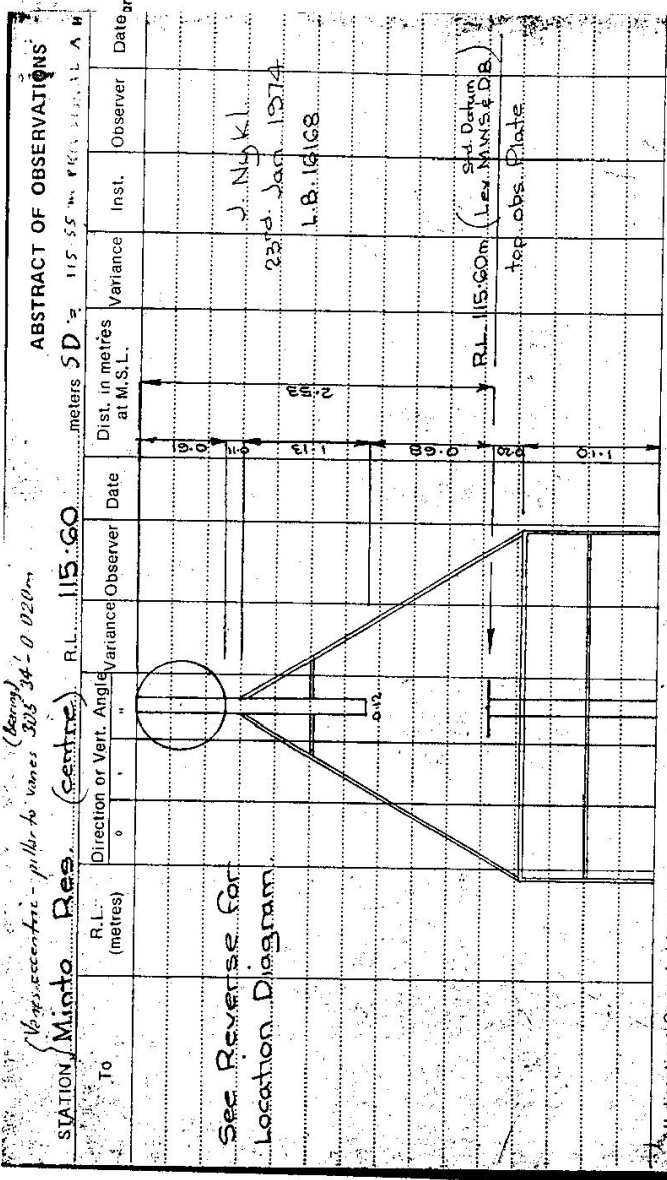

All directions Corrected to centre

All Vert's corrected ground to ground

14. Diff. Ht. is m. above below
 15. Diff. Ht. is m. above below
 16. Diff. Ht. is m. above below
- Prepared by: _____ Checked: _____


Date Record of Station

STATION **MINTO (P) TS 3129**

Owners Name..... Current Occupant.....

Address..... Address.....

Not to Scale

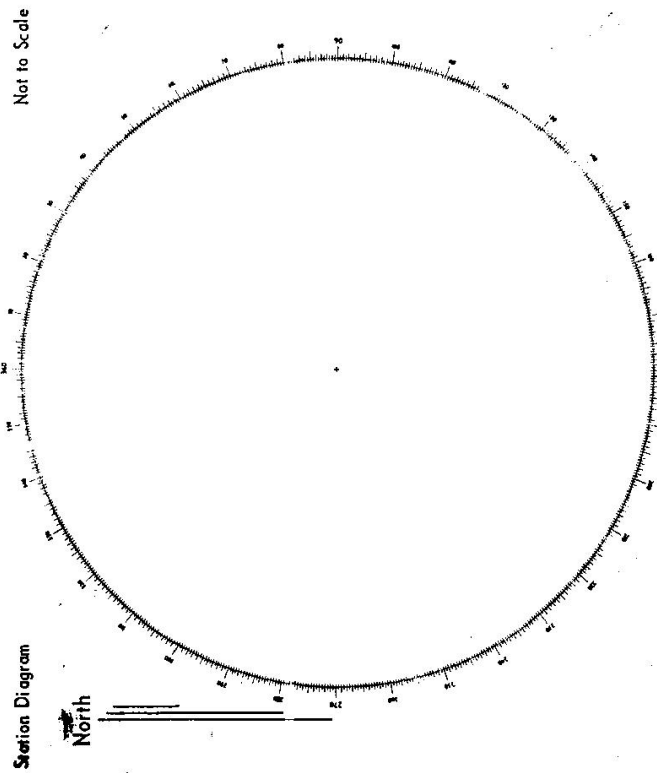

List of Observed Directions:-

Standpoint:		Standpoint:	
Station	Direction	Station	Direction

