

75-10



STATION TS 3134 MISERY RES

Co: \_\_\_\_\_ Ph: \_\_\_\_\_  
 Map Sheet: \_\_\_\_\_ No: \_\_\_\_\_  
 Inspected by: \_\_\_\_\_ Date: \_\_\_\_\_  
 Authority: \_\_\_\_\_ Field Book: \_\_\_\_\_

Beacon Diagram Not to Scale

RECONNAISSANCE and MAINTENANCE REPORT

Integrated Survey of N.S.W.

Note: Cross out word or words which do not apply

This Trig. Station has been:-

1. Completely cleared to permit 360° vision to surrounding Trigs.
2. Cleared by lanes bearing

STATION MOUNTAIN		MISERY RES		R.L. 67.0		F OBSERVATIONS	
R.L. RE (metres)	Direction or Vert. Angle	Observer	Date	Dist. in metres at M.S.L.	Variance	Inst.	Observer
EYE				2.01m			
METAL PLATFORM MARK				00m			
CAT. WALK AROUND TANK							
METAL SIDES PAINTED SILVER							

Water

NOT TO SCALE  
FB 1951 RES Page 8

All Vert's corrected ground to ground

SEE REAR OF CARD FOR REMARKS

14. Diff. Ht. .... is ..... m. above below
15. Diff. Ht. .... is ..... m. above below
16. Diff. Ht. .... is ..... m. above below

Prepared by: \_\_\_\_\_ Checked: \_\_\_\_\_

Date: \_\_\_\_\_ Record of Station

STATION ~~XXXX~~ MOUNT MISERY RES TS 3134

Current Occupant.....

Owners Name.....

Address.....


Address.....

Access.....

Not to Scale


Station Diagram

North

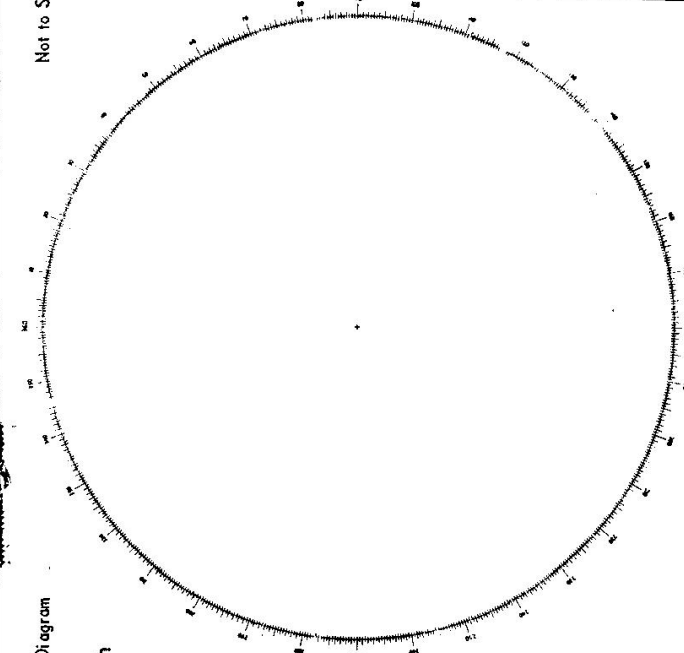

List of Observed Directions:-

Station	Direction	Distance	Station
SEAS			
Waltham's Park			
Monkwear Bridge	84° 46'	00 R.O.	
Bankstown Res	91 51		
Conville Park Res	103 15		
Pennington Res	116 47		
			58
Loftus Res	159 42		
B.L.O.C.K.E.D.	TO WEST		
	Very hazy when visited.		

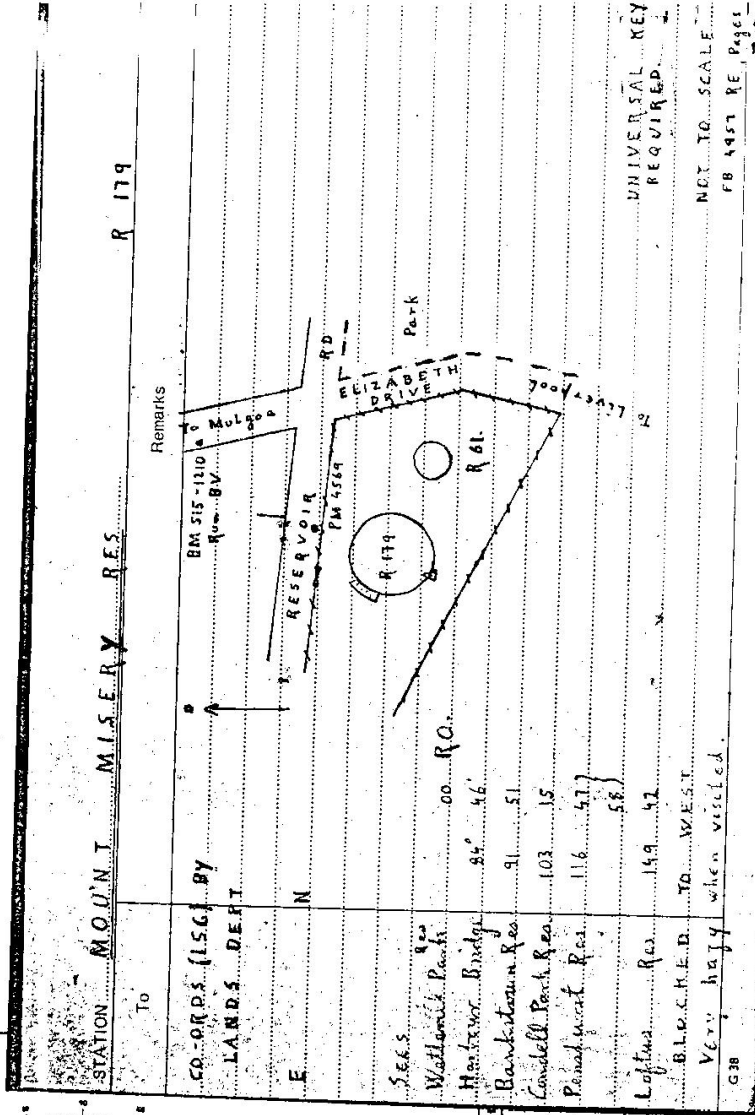

D. West, Government Printer, New South Wales - 1976

FB 14957 RE 7-10


7.5.10.3

Department of Lands  
 Integration Survey of N.S.W.  
 RECONNAISSANCE and MAINTENANCE REPORT

STATION MISERY RES 3134

Co: \_\_\_\_\_ Ph: \_\_\_\_\_  
 Map Sheet: \_\_\_\_\_ No: \_\_\_\_\_  
 Inspected by: C. Starkey Date: 28/8/75  
 Authority: \_\_\_\_\_ Field Book: 684 87

Beacon Diagram Not to Scale

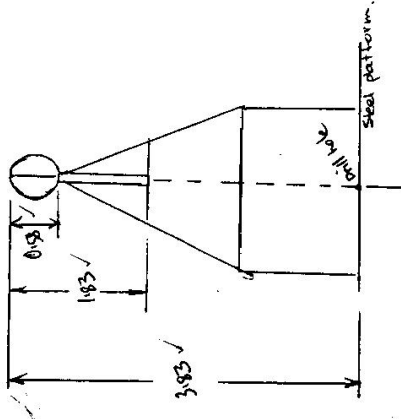

NB See report on WILSON TS for further to connection between WILSON TS & MISERY TS.

Date: \_\_\_\_\_ Record of Station: \_\_\_\_\_  
 6/1/78 R. Cobis Trig. Details & description of Markings  
 See PDF books.

Note: Cross out word or words which do not apply

1. Completely cleared to permit 360° vision to surrounding Trigs.
2. Cleared by lanes bearing 70°M to 90°M 2.180°M from Trig. Mast
3. Trig. Mast & Vanes have been painted white & black respectively.
4. The Trig. was unpiled/~~not unpiled~~, dimensions now being:  
 Description of mark. Drill hole in steel platform. should be explicit, e.g. Steel plug, Brass plug, Bolt, Concrete Pillar  
 Height of mark: \_\_\_\_\_ m above ~~rock/concrete~~ \_\_\_\_\_ m above ~~rock/concrete~~ below G.L.  
 Height of Top Vanes to Top Mark/Top pillar plate: 3.83 m Diameter of Vanes (vertical): 0.58 m.  
 Height of Cairn: \_\_\_\_\_ m. Diameter of Cairn: \_\_\_\_\_ m.  
 Length of Mast 1.83 m. (approximate if not unpiled)  
 A. <sup>1</sup>/<sub>1</sub> Tree set in conc/rock has been placed/fd 5.405 m. bearing 298°M from Trig. Mast/pillar  
 A. <sup>1</sup>/<sub>1</sub> Tree set in conc/soil has been placed/fd 2.297 m. bearing 37°M from Trig. Mast/pillar  
 A. <sup>1</sup>/<sub>1</sub> Tree set in conc/soil has been placed/fd 100.167 m. bearing 92°M from Trig. Mast/pillar  
 A. \_\_\_\_\_ set in conc/rock has been placed/fd \_\_\_\_\_ m. bearing \_\_\_\_\_°M from Trig. Mast/pillar

9. Connection. Concrete Plate <sup>1</sup>/<sub>1</sub> Tree: 6.213 m. bearing 277°M
10. Connection: \_\_\_\_\_ to \_\_\_\_\_ m. bearing \_\_\_\_\_°M
11. Connection: \_\_\_\_\_ to \_\_\_\_\_ m. bearing \_\_\_\_\_°M
12. Connection: \_\_\_\_\_ to \_\_\_\_\_ m. bearing \_\_\_\_\_°M
13. Diff. Ht. G.I. NAIL PLACED is 7.84 m. <sup>above</sup>/<sub>below</sub> TRIG. (Drill hole)
14. Diff. Ht. Concrete Block is 0.075 m. <sup>above</sup>/<sub>below</sub> G.I. NAIL PLACED
15. Diff. Ht. <sup>1</sup>/<sub>1</sub> Tree is 1.83 m. <sup>above</sup>/<sub>below</sub> G.I. NAIL PLACED
16. Diff. Ht. \_\_\_\_\_ is \_\_\_\_\_ m. <sup>above</sup>/<sub>below</sub> \_\_\_\_\_


Prepared by: C. STARKEY Checked: Duffy

STATIONTS 3134. MISERY RES

Owners Name.....  
 Current Occupant.....  
 Address.....  
 Address.....

28-8-1975  
 ON RESERVOIR ON ELIZABETH DRIVE AT GREEN VALLEY.

Not to Scale

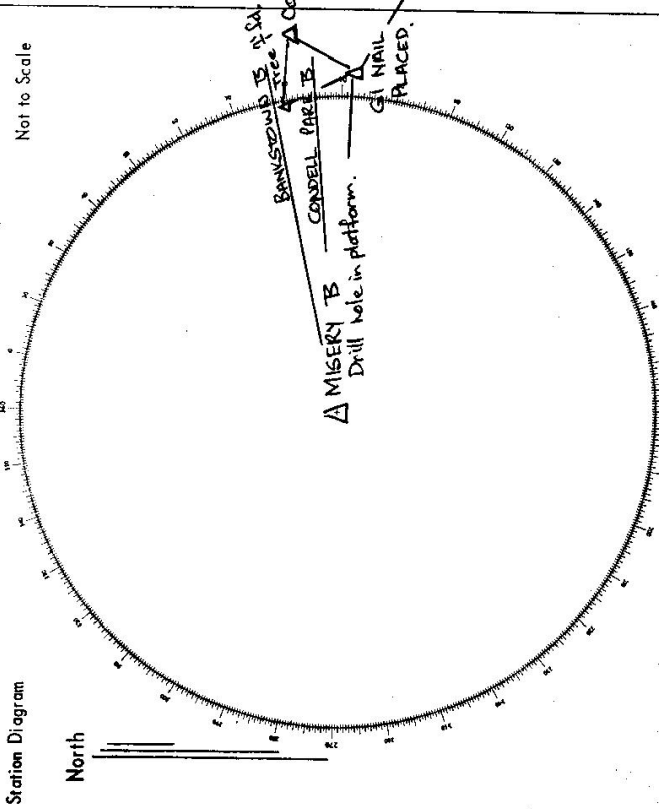

List of Observed Directions:-

Station	Direction	Station	Direction
BANKSTOWN TS	0° 00' 00"	WILSON TS	0° 00' 00"
CONDELL PARK TS	7° 45' 14.5"	MOOREBANK TS	15° 41' 38.5"
GI NAIL PLACED	14° 53' 04.8"	MISERY TS	150° 10' 41.5"
		TREE SA	176° 05' 40"
		CONCRETE BLOCK SA	215° 51' 01"
		BANKSTOWN TS	315° 10' 58.3"
STATIONTS 3134. MISERY RES			
Station	Direction	Station	Direction
MISERY TS	0° 00' 00"		
TREE SA	5° 43' 12"		
GI NAIL PLACED	306° 42' 3.4"		