

GEODETIC SURVEY OF M.S.W.

CENTRAL MAPPING AUTHORITY

GEODETIC STATION RECONNAISSANCE and MAINTENANCE REPORT

Description:

Note: Cross out word or words which do not apply

1. Cleared by lanes bearing.....
2. Mast & Vanes have been painted white & black respectively. found in cairn of rock.
3. The station/pillar was unpiled/not unpiled/constructed on.....19....., dimensions now being: Description of mark.....should be explicit, e.g., S/Steel Pillar Plate, Steel plug, Brass plug, Bolt, G.I. Pipe
- Height of mark.....m. ^{above} _{below} rock/concrete; Mark is.....m. ^{above} _{below} G.I.L.
- Height of Top Vanes to Top Mark/Pillar platem. Diameter of Vanes (vertical).....m.
- Height of Cairn.....m. Diameter of Cairn.....m. Name Plate found/not found/placed.
- Length of Mastm. (approximate if not unpiled)
4. A.....set in conc/rock has been placed/found, bearing.....° M from Mast/Plug/Pillar
5. A.....set in conc/rock has been placed/found, bearing.....° M from Mast/Plug/Pillar
6. A.....set in conc/rock has been placed/found, bearing.....° M from Mast/Plug/Pillar
7. A.....set in conc/rock has been placed/found, bearing.....° M from Mast/Plug/Pillar

8. Action required: *Always Clearing. Mast & Vanes need painting..*

STANDPOINT:

Mark	Direction	Horiz. Distance	Height Difference	Mark	Direction	Horiz. Distance	Height Difference
			above standpt. below				above standpt. below
			above standpt. below				above standpt. below
Prepared by: *[Signature]*

Checked:

Noted on U.T.M. Card


St 2733-1

STATION: MOMMO No.: 3156

MAP SHEET SCALE 1:250 000 Narraoaine

INSPECTED BY: P.K. Bamola DATE: Aug 78

AUTHORITY: CMA FIELD BOOK:

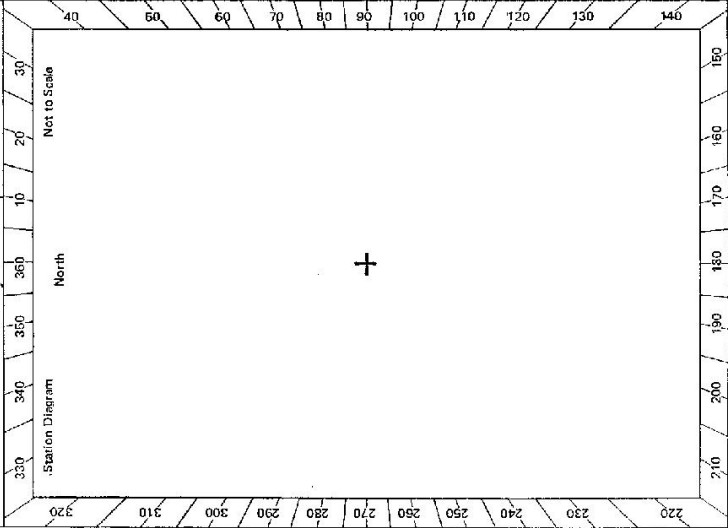

Checked

812733--2 D. West, Government Printer

<p>Beacon Diagram</p>	<p>Not to Scale</p>	<p style="text-align: right; font-weight: bold;">STATION <i>Momo</i> TS <i>3156</i></p> <p>Owner's Name: Address: Phone:</p> <p>Current Occupant: Address: Phone:</p> <p>Aug 1978 Access Report of/19..... was found suitable/unsuitable. ACCESS <i>Refer Sappa Bulga 1:50 000 Sheet.</i> <i>20 mins walk from Newell Highway</i></p>
<p>This section to be completed by officer constructing pillar.</p> <p>Original station mark found/not found.</p> <p>Description of mark:</p> <p>Original beacon found/not found.</p> <p>Description of beacon:</p> <p>Height Top of Vanes to Top Mark.....m.</p> <p>Height of mark.....m. above rock/cont.....m. below G.L.</p> <p>Diameter of Vanes.....m. Height of Cairn.....m.</p> <p>Original Beacon has/has not been destroyed by me.</p>		<p>Date</p> <p>Record of Station</p>