

74-98


CENTRAL MAPPING AUTHORITY
 Department of Lands
 Trigonometrical Survey of N.S.W.
 RECONNAISSANCE and MAINTENANCE REPORT

STATION **MOODY** TS **3170**
 Co: **Salwyn** Ph: **Hay**
 Map Sheet: **Yarongobilly** No: **8526**
 Inspected by: **N. D. Benge** Date: **15th December 1976**
 Authority: **Central Mapping** Field Book: **8076**

This Trig. Station has been:-
 Note: Cross out word or words which do not apply

1. Completely cleared to permit 360° vision to surrounding Trig.
2. Cleared by Jones-bearing *Clearing required* from Trig. Mast.
3. Trig. Mast & Vanes have been painted white & black respectively. *See Diagram*
4. The Trig. was ~~unpiled~~ not unpiled, dimensions now being: Original Station Mark ~~found~~ not found
 Description of mark..... should be explicit, e.g. Steel plug, Brass plug, Bolt, G.I. Pipe
 Height of mark..... m above rock/concrete m above G.L.
 Height of Top Vanes to Top Mark..... m. Diameter of Vanes (vertical) *See Diagram*
 Height of Cairn..... 2.3 m. Diameter of Cairn *See Diag.* m.
 Length of Mast *See Diag.* m. (approximate if not unpiled)

5. A..... set in conc/rock has been placed..... m. bearing.....°M from Trig. Mast
6. A..... set in conc/soil has been placed..... m. bearing.....°M from Trig. Mast
7. A..... set in conc/soil has been placed..... m. bearing.....°M from Trig. Mast
8. A..... set in conc/rock has been placed..... m. bearing.....°M from Trig. Mast
9. Connection..... to..... m. bearing.....°M *Note: Site difficult for pillar placement.*
10. Connection..... to..... m. bearing.....°M
11. Connection..... to..... m. bearing.....°M
12. Connection..... to..... m. bearing.....°M
13. Diff. Hr. is..... m. above below
14. Diff. Hr. is..... m. above below
15. Diff. Hr. is..... m. above below
16. Diff. Hr. is..... m. above below

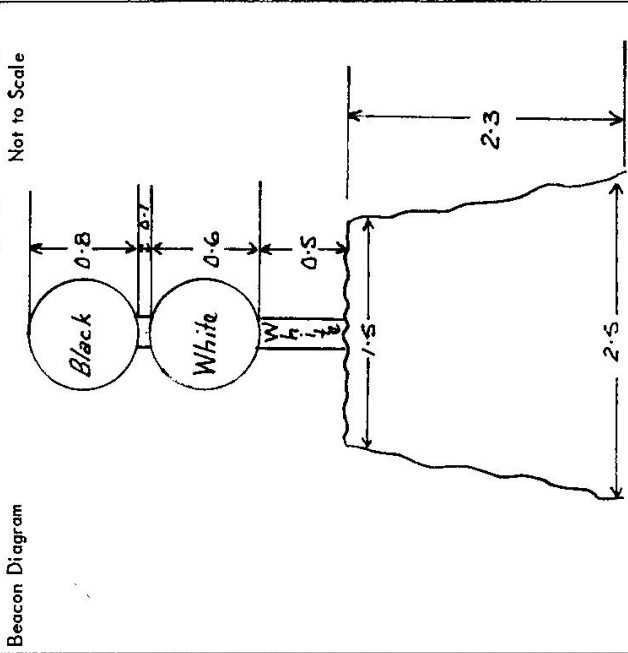

Date	Record of Station
	4.3

Prepared by: *N. Benge* Checked: *N. D. Benge* Noted on U.T.M. Card

Checked

