

CENTRAL MAPPING AUTHORITY

GEODETIC SURVEY OF M.S.W.

GEODETIC STATION RECONNAISSANCE and MAINTENANCE REPORT

STATION: **MIDGENILLA G.S.** No.: **3171**

MAP SHEET SCALE 1:250 000 **MARDOMINE**

INSPECTED BY: **R. COOK** DATE: **SEP 1978**

AUTHORITY: **C.M.A.** FIELD BOOK:

Description: *Note: Cross out word or words which do not apply*

1. Cleared by lanes bearing..... from Trig. Mast
2. Mast & Vanes have been painted white & black respectively.
3. The station/pillar ~~was~~ *is* not unpiled/constructed on.....19....., dimensions now being: Description of mark.....*S.L.D.*.....should be explicit, e.g., S/Steel Pillar Plate, Steel plug, Brass plug, Bolt, G.I. Pipe
Height of mark.....*3.0*.....m. ^{above} rock/concrete; Mark is.....*below* G.L.
Height of Top Vanes to Top Mark/Pillar platem. Diameter of Vanes (vertical).....*2.7*.....m.
Height of Cairn.....*1.7*.....m. Diameter of Cairn.....*3.2*.....m. Name Plate found/not found/placed.
Length of Mast.....*2.7*.....m. (approximate if not unpiled)
4. A.....set in conc/rock has been placed/found, bearing.....° M from Mast/Plug/Pillar
5. A.....set in conc/rock has been placed/found, bearing.....° M from Mast/Plug/Pillar
6. A.....set in conc/rock has been placed/found, bearing.....° M from Mast/Plug/Pillar
7. A.....set in conc/rock has been placed/found, bearing.....° M from Mast/Plug/Pillar
8. Action required: *nests. Retaining, no clearing needed. Suitable for pillar.....*


STANDPOINT:

Mark	Direction	Horiz. Distance	Height Difference	Mark	Direction	Horiz. Distance	Height Difference
			above standpt.				above standpt.
			below				below
			above standpt.				above standpt.
			below				below
Prepared by: **R. COOK**

Checked: *U.T.M. Carr*

St 2738-1

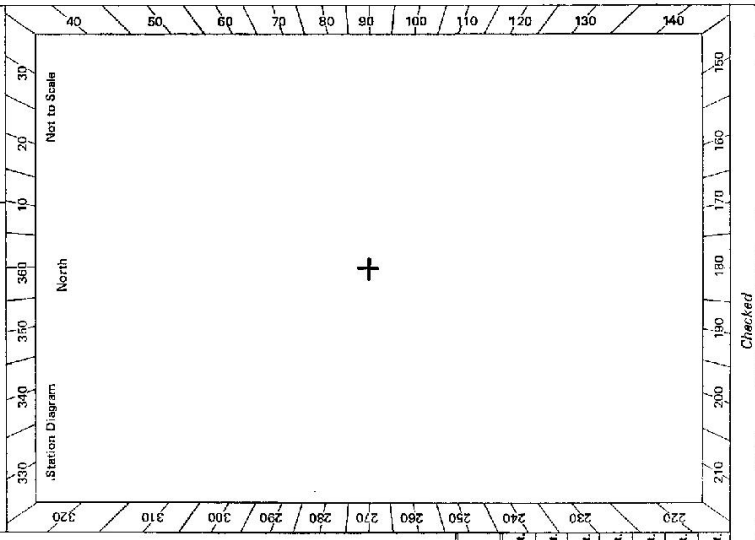

St 2733-2 D. Wier, Government Printer

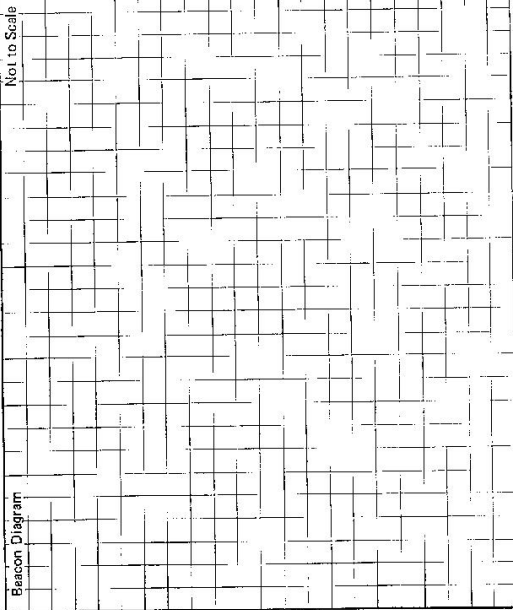

This section to be completed by officer constructing pillar.

Original station mark found/not found.

Description of mark:

Original beacon found/not found.

Description of beacon:

Height Top of Vanes to Top Markm.

Height of markm. above G.L.
below

Diameter of Vanesm. Height of Cairnm.

Original Beacon has/has not been destroyed by me.

STATION MOOGENILLA G. S. TS 3171	
Owner's Name:	Current Occupant:
Address:	Address:
Phone:	Phone:
<p style="text-align: center;"><u>ACCESS</u></p> <p style="text-align: center;">Sept 1978 Access Report of/19 was found suitable/suitable.</p> <p style="text-align: center;">3 minute walk from the base of the Hill. found on the Boona 1:50,000 sheet.</p>	
Date	Record of Station
SEPT. 1978	STAT 1002 VISITED IN CONNECTION WITH FIELD COMPLETION