

GEODETTIC SURVEY OF N.S.W.

CENTRAL MAPPING AUTHORITY

GEODETTIC STATION RECONNAISSANCE and MAINTENANCE REPORT

STATION: *MOCKIMA G.S.* No.: *3173*

MAP SHEET SCALE 1:250 000 *GRAFTON*

INSPECTED BY: *M.L. Moerisen* DATE: *16/10/73*


AUTHORITY: *CMA* FIELD BOOK: *1795*

- Description: *Note: Cross out word or words which do not apply*
- Cleared by lanes bearing..... from Trig, Mast
 - Mast & Vanes have been painted white & black respectively.
 - The station/pillar was unpiled/not unpiled/constructed on..... 19....., dimensions now being: Description of mark.....should be explicit, e.g., S/Steel Pillar Plate, Steel plug, Brass plug, Bolt, G.I. Pipe
- Height of mark.....m, ^{above}/_{below} rock/concrete; Mark is.....m, ^{above}/_{below} G.L.
- Height of Top Vanes to Top Mark/Pillar platem. Diameter of Vanes (vertical).....m.
- Height of Cairn.....m. Diameter of Cairn.....m. Name Plate found/not found/placed.
- Length of Mastm. (approximate if not unpiled)
- A.....set in conc/rock has been placed/found, bearing.....° M from Mast/Plug/Pillar
 - A.....set in conc/rock has been placed/found, bearing.....° M from Mast/Plug/Pillar
 - A.....set in conc/rock has been placed/found, bearing.....° M from Mast/Plug/Pillar
 - A.....set in conc/rock has been placed/found, bearing.....° M from Mast/Plug/Pillar
8. Action required:.....


STANDPOINT:

Mark	Direction	Horiz. Distance	Height Difference	Mark	Direction	Horiz. Distance	Height Difference
			above standpt				above standpt
			below standpt				below standpt
			above standpt				above standpt
			below standpt				below standpt
Prepared by: *[Signature]* Checked: *[Signature]* *Noted on U.T.M. Card*

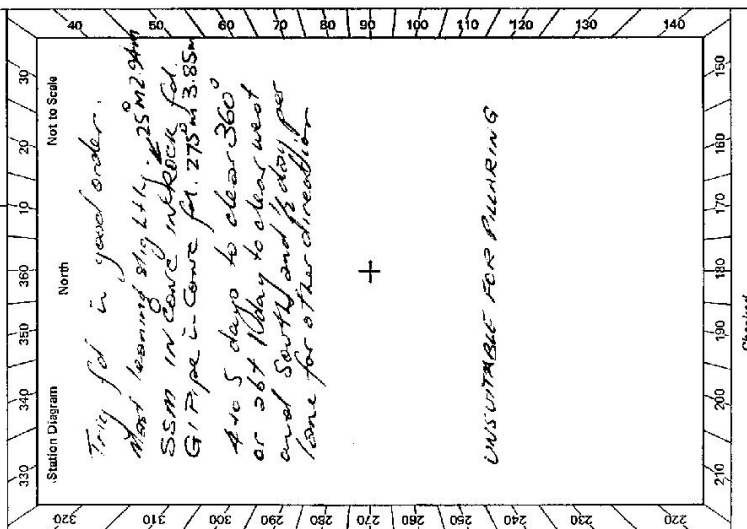

St: 2733-2 D. West, Government Printer

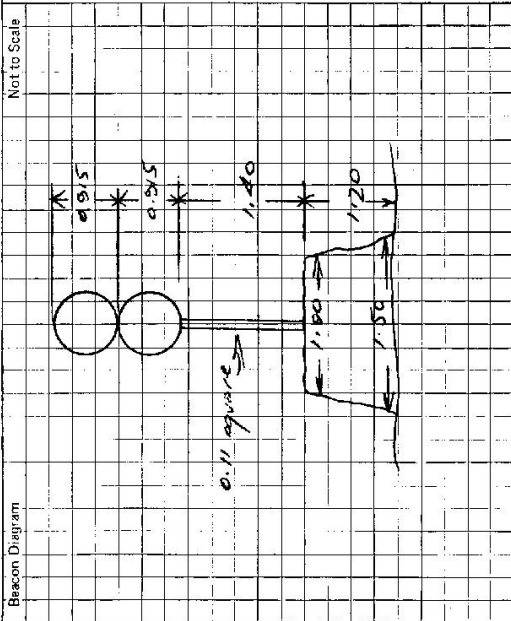

This section to be completed by officer constructing pillar.

Original station mark found/not found.

Description of mark:

Original beacon found/not found.

Description of beacon:

Height Top of Vanes to Top Mark.....m.

Height of mark.....m. above G.L. below

Diameter of Vanesm. Height of Cairnm.

Original Beacon has/has not been destroyed by me.

STATION Mookina TS 3173	Owner's Name: MR GEORGE MAITI Address: BOJURA STN UPPER FINE FLOWER FINE FLOWER OBJECT 2 Phone:
Current Occupant:	Address:
Phone:	Phone:
ACCESS	
Access Report of 16/10/19 was found suitable/unsuitable.	
Km	Direction
0.00	BARYULGIL RD. HEAD TOWARDS TABULAM
0.26	TURN RIGHT SIGN TABULAM SS
8.43	TURN RIGHT OVER GRID AT WHITE AN GULLAN DRUM RIMB R WILSON DEEP CREEK
9.10	GRID
10.37	PASS TRACK ON LEFT THAT CROSSES CREEK.
10.55	11.86, 12.65 GATE, GRID, GATE
12.73	STRAIGHT AHEAD PAST TRACK ON RIGHT
13.99	RAIL GATE (OR SIDE W/ WAGGONS - BOTH SID)
14.70	GATEWAY
15.37	THROUGH GATE JUST PAST TRACK ON LEFT
15.85	JUST AFTER CREEK CROSSING NEAR SLEEPER CUTTERS CAMP TAKE RIGHT HAND FORK
16.04	TAKE LEFT HAND FORK
16.52	TAKE LEFT HAND FORK
18.40	TAKE RIGHT HAND BIG THREE TRACKS
18.76	CROSS CREEK MAKE WAY AROUND WASHED OUT CUTTING
19.03	TAKE RIGHT HAND FORK
20.50	WIRE GATE
20.30	TAKE LEFT FORK
21.00	TURN RIGHT BACK UP SPUR
21.94	TAKE TRACK TO LEFT
22.06	PARK TRACK AT DOUBLE TUCK FENCES. CROSS FENCES AND HEAD UP STEEP ROCKY SLOPE TO TR 9. APT 25M AND WALK TO TR 9 WITH LOAD.

Record of Station

Date

9.5.80

Mr G Whitt gives permission for clearing and maintenance of Mookina

GEODETTIC SURVEY OF M.S.W.

CENTRAL MAPPING AUTHORITY

GEODETTIC STATION RECONNAISSANCE and MAINTENANCE REPORT

Description:

Note: Cross out word or words which do not apply


1. Cleared by lanes bearing $225^{\circ} 15' 00''$ and $160^{\circ} 15' 00''$ from Trig. Mast
2. Mast & Vanes have been painted white & black respectively.
3. The station/pillar was unpiled/~~was~~ on 19^{th} July 1980, dimensions now being: This MARK is shown as Such Australian Survey Loran Triangulation Station
Description of mark Brass Plate, Steel plug, Brass plug, Bolt, G.I. Pipe
Height of mark 1.40 m. ~~above~~ ^{above} ~~concrete~~ ^{concrete} Mark is 1.40 m. ~~above~~ ^{above} ~~G.L.~~ ^{G.L.}
Height of Top Vanes to Top Mark 4.520 m. Diameter of Vanes (vertical) 0.915 m. 2×0.915 m.
Height of Cairn 1.40 m. Diameter of Cairn 1.40 m. Name Plate ~~found~~ ^{found} /placed.
Length of Mast 4.520 m. (approximate if not supplied) ON Bottom Trig. Vanes.
4. A 5.827 m. set in ~~conc~~ /rock has been placed/round, bearing $276^{\circ} 04' 37''$ M from Mast/Plug/Pillar
5. A 3.827 m. set in ~~conc~~ /rock has been placed/round, bearing $276^{\circ} 04' 37''$ M from Mast/Plug/Pillar
6. A 2.974 m. set in ~~conc~~ /rock has been placed/round, bearing $276^{\circ} 04' 37''$ M from Mast/Plug/Pillar
7. A 3.827 m. set in ~~conc~~ /rock has been placed/round, bearing $276^{\circ} 04' 37''$ M from Mast/Plug/Pillar
8. Action required:

Mark	Direction	Horiz. Distance	Height Difference	Mark	Direction	Horiz. Distance	Height Difference
BARCELLOTT (P)	$0^{\circ} 00' 00''$		above standpt.	BARCELLOTT (P)	$0^{\circ} 00' 00''$		above standpt.
G.I. pipe	$54^{\circ} 17' 14.5''$	3.827	above standpt.	G.I. pipe	$25^{\circ} 43' 10.5''$	5.682	below standpt.
S.S.M.	$167^{\circ} 27' 36.5''$	2.974	above standpt.	Masth G.S.	$276^{\circ} 04' 37''$		above standpt.
Masth G.S.	$276^{\circ} 04' 37''$		below standpt.	CAMELBACK (P)	$340^{\circ} 50' 37''$		below standpt.
CAMELBACK (P)	$340^{\circ} 50' 22''$		above standpt.	Trig. Plug	$347^{\circ} 25' 48''$	2.957	above standpt.
CANTHAM NEW (P)	$359^{\circ} 35' 04''$		below standpt.	CANTHAM NEW (P)	$359^{\circ} 35' 04''$		below standpt.

Prepared by: *TRIG. PLAQUE* Noted on U.T.M. Card

Checked: *TRIG. PLAQUE*

Station Diagram

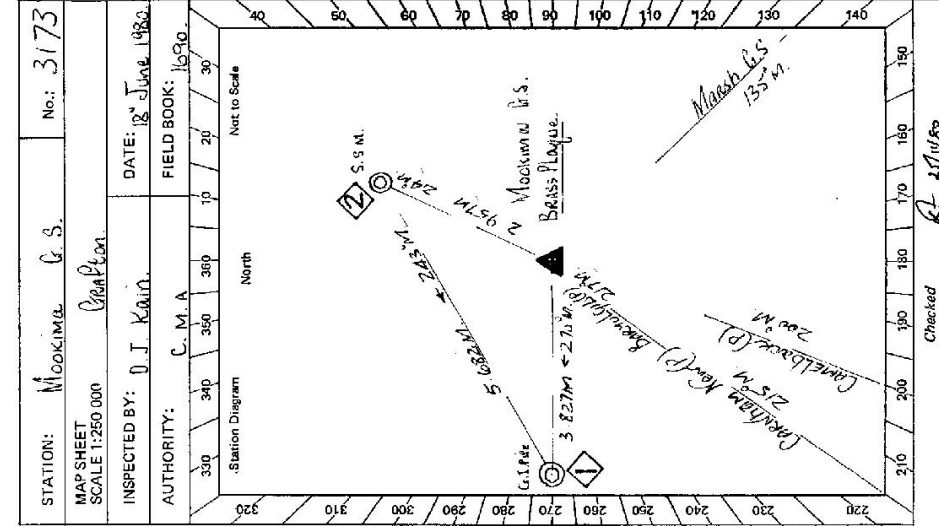

STATION: *Mookimul G.S.* No.: *3173*

MAP SHEET SCALE 1:250 000

INSPECTED BY: *D.J. Kain* DATE: *18 June 1980*

AUTHORITY: *C.M.A.* FIELD BOOK: *1690*

Checked *R. 27/4/80*

SI 2732-2 D. West, Government Printer

STATION MOOKMA G.S. TS 3173	Owner's Name: MR. GEORGE W. SMITH Address: BOULEVARD STANLEY, UPPER GINE PLAINS Phone: KINE PLAINS CREEK 2
Current Occupant: Address: Phone:	
ACCESS	
Access Report of 16/10/1979 was found suitable/suitable Kilometres	
Features: 0.0. BRISBANE Post Office, head towards TABULAM. 0.26 Turn Right, SIGN, TABULAM 55. 8.43 TURN RIGHT OVER GRID AT WHITE 44 GALLON DUM, RAILS R. WILSON Deep Creek 9.10 GRID 10.37 Pass Track on Left That crosses creek. 11.26, 12.69, GATE, GRID, GATE. 12.59 STRAIGHT AHEAD Past Track on right. 13.99 WOOD RAIL GATE (OR STEEL one nearby both used.) 14.70 GATEWAY. 15.57 THROUGH GATE JUST Past Track on Left. 15.85 JUST AFTER CREEK CROSSING NEAR SLEEPER CUTTERS CAMP, TAKE Right hand Fork 16.04 TAKE Left hand Fork 16.42 TAKE Left hand Fork 18.40 TAKE Right hand Fork of Three Tracks. 18.76 CROSS CREEK, MAKE WAY AROUND WASHED OUT cutting. 19.03 TAKE Right hand Fork. 20.50 WIRE GATE 20.90 TAKE Left Fork 21.00 TURN RIGHT AND BACK UP SPUR 21.94 TAKE TRACK TO LEFT, 22.00 PARK TRACK AT DOUBLE JICK FENCES CROSS FENCES AND head UP STEEP ROLLY GIVE TO THE NUMBER OF STATION	
Date	
Not to Scale	
This section to be completed by officer constructing pillar.	
Original station mark found/ not found . Description of mark: SEVEN PINE TREES Original beacon found/ not found . Description of beacon: POLE Height Top of Vane to Top Mark 4.570m. Height of marking 2 x 0.15 m. above wood/conc. 2 x 0.15 m. below G.L. belowm. Diameter of Vane 1.5m. Height of Cairn 1.25m. Original Beacon was /has not been destroyed by me.	