

LAND INFORMATION CENTRE

GEODETTIC SURVEY OF A.S.W.

GEODETTIC STATION RECONNAISSANCE and MAINTENANCE REPORT

STATION: Moree Tracking Station No: 3191

MAP SHEET SCALE 1:250 000

INSPECTED BY: D. Kain

DATE: 7-8-93

AUTHORITY: L.I.C.


FIELD BOOK: ---

- Description:
- Cleared by lanes bearing..... from Trig. Mast
 - Mast & Vanes have been painted white & black respectively.
 - The station/pillar was unpiled/not unpiled/constructed on.....19....., dimensions now being:
 - Description of mark.....should be explicit, e.g., S/Steel Pillar Plate, Steel plug, Brass plug, Bolt, G.I. Pipe
 - Height of mark.....m. ^{above} rock/concrete; Mark is.....m. ^{above} G.L. _{below}
 - Height of Top Vanes to Top Mark/Pillar platem. Diameter of Vanes (vertical).....m.
 - Height of Cairn.....m. Diameter of Cairn.....m. Name Plate found/not found/placed.
 - Length of Mastm. (approximate if not unpiled)
 - A.....set in conc/rock has been placed/found, bearing.....°M from Mast/Plug/Pillar
 - A.....set in conc/rock has been placed/found, bearing.....°M from Mast/Plug/Pillar
 - A.....set in conc/rock has been placed/found, bearing.....°M from Mast/Plug/Pillar
 - A.....set in conc/rock has been placed/found, bearing.....°M from Mast/Plug/Pillar

8. Action required:.....

STANDPOINT:				STANDPOINT:			
Mark	Direction	Horiz. Distance	Height Difference	Mark	Direction	Horiz. Distance	Height Difference
			above standpt.				above standpt.
			below				below
			above standpt.				above standpt.
			below				below
Prepared by: D. Kain Checked: AD 24/8/93 Noted on U.T.M. Card

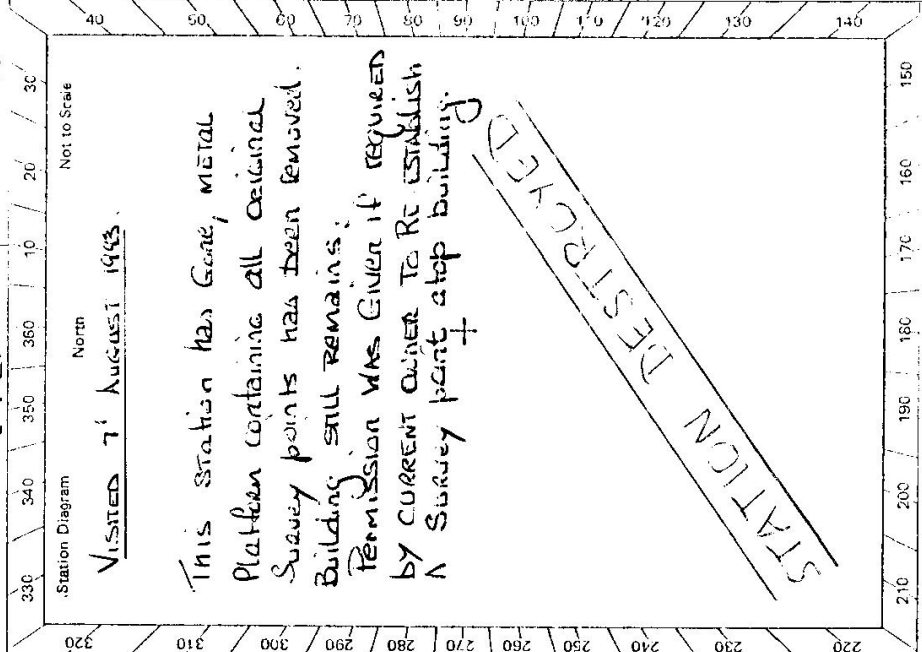


© 2733-2 D. West, Government Printer

Beacon Diagram	Not to Scale
<p>North West Irrigation Pty Limited (Formerly Corderoy Industrial Supplies) OLD OTG STATION MUNGINDI ROAD, MOREE, N.S.W., 2400 UHF – CHANNEL 6</p> <p>Dan Hennessy DIRECTOR Irrigation Suppliers & Manufacturers</p> <p>GOONDIWINDI 35 Elizabeth Dve Phone: (076) 712 912 Fax: (076) 711 872 A/H: (076) 712 912</p> <p>MOREE P.O. Box 814 Phone: (067) 522 751 Fax: (067) 524 571 Mobile: 078 700 758</p>	

STATION **Moree Tracking Station** TS **3197**

Owner's Name:
 Current Occupant:
 Address:
 Phone:
 ACCESS **7-8-1993**
 id suitable/unsuitable.

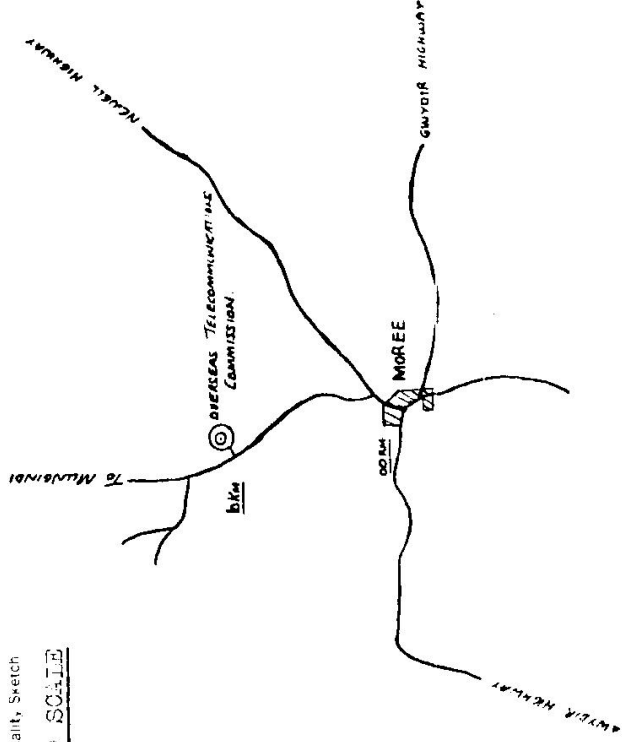

This section to be completed by officer constructing pillar.

Original station mark found/not found.

Description of mark:

Original beacon found/not found.

Description of beacon:

Height Top of Vanes to Top mark.....m.

Height of mark.....m. above rock/conc.....m. below G.L.

Diameter of Vanes.....m. Height of Cairn.....m.

Original Beacon has/has not been destroyed by me.

Date