

CENTRAL MAPPING AUTHORITY

Department of Lands

Trigonometrical Survey of N.S.W.

RECONNAISSANCE and MAINTENANCE REPORT

This Trig. Station has been:-

Note: Cross out word or words which do not apply

1. Completely cleared to permit 360° vision to surrounding Trigs.
2. Cleared by lanes bearing..... from Trig. Mast
3. Trig. Mast & Vanes have been painted white & black respectively.
4. The Trig. was unpiled/not unpiled, dimensions now being: Original Station Mast 6' dug / iron four /

Description of mark..... should be explicit, e.g. Steel plug, Brass plug, Bolt, G.I. Pipe
 Height of mark..... m above rock/concrete
 Height of Top Vanes to Top Mark..... m.
 Height of Cairn..... m. Diameter of Cairn..... m.
 Length of Mast..... m. (approximate if not unpiled). Diameter of Vanes (vertical)..... m.

5. A..... set in conc/rock has been placed..... m. bearing..... °M from Trig. Mast
6. A..... set in conc/soil has been placed..... m. bearing..... °M from Trig. Mast
7. A..... set in conc/soil has been placed..... m. bearing..... °M from Trig. Mast
8. A..... set in conc/rock has been placed..... m. bearing..... °M from Trig. Mast

9. Connection to..... m. bearing..... °M
10. Connection to..... m. bearing..... °M
11. Connection to..... m. bearing..... °M
12. Connection to..... m. bearing..... °M

13. Diff. Ht. is..... m. above
..... m. below
14. Diff. Ht. is..... m. above
..... m. below
15. Diff. Ht. is..... m. above
..... m. below
16. Diff. Ht. is..... m. above
..... m. below

Prepared by: *G. C. Hanna*

Checked:

Noted on U.T.M. Card

STATION MORRICE TS 3207

Co: Goulburn

Ph: Mountain Creek

Map Sheet: Halbrook

No. 8326-S

Inspected by: G.C. Hanna

Date: 15/12/76

Authority:

Field Book:

Beacon Diagram

Net to Scale

Date


Record of Station

Checked

STATION MORRICE TS 3207


Owners Name.....
 Address.....
 Access 15-12-1916

Current Occupant.....
 Address.....
 Access 15-12-1916

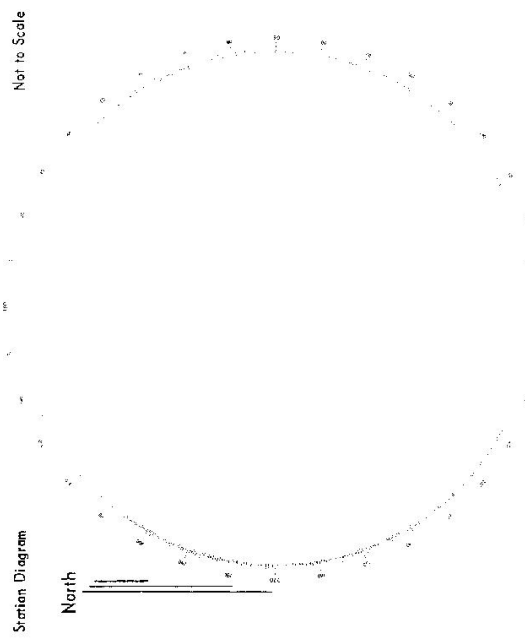

List of Observed Directions:-

Standpoint:		Standpoint:	
Station	Direction	Station	Direction

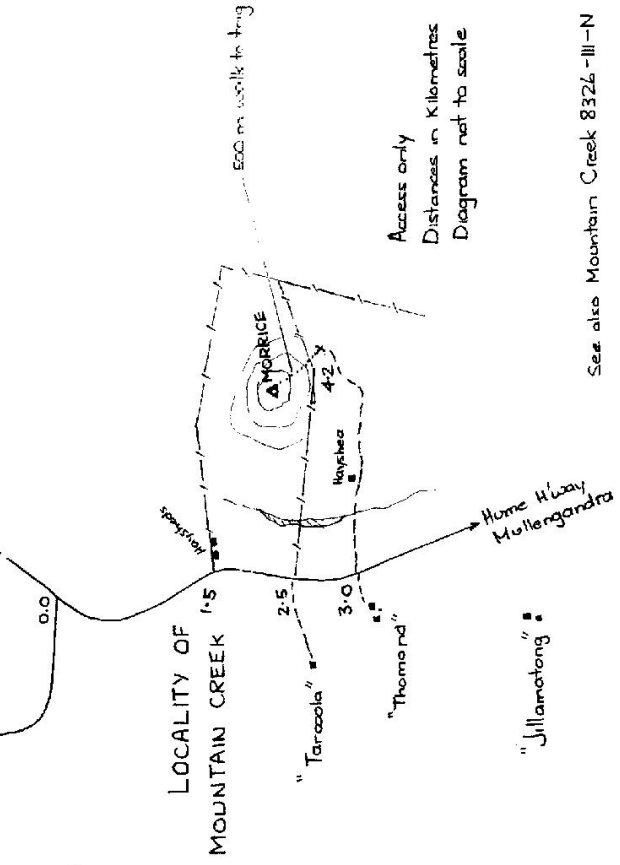

Access only
 Distances in Kilometres
 Diagram not to scale

See also Mountain Creek 8326-III-N