

LAND INFORMATION CENTRE

GEODETIC SURVEY OF N.S.W.

GEODETIC STATION RECONNAISSANCE and MAINTENANCE REPORT

STATION: MORROW TS No.: 3210

MAP SHEET SCALE 1:250 000 NYHAGEE GINDOONO 1:100 000

INSPECTED BY: G. FORD DATE: 21-9-99

AUTHORITY: L. I. C. FIELD BOOK: —

Description:

Note: Cross out word or words which do not apply
 Clear for G.P.S. from Trig. Mast

1. Cleared by Janes bearing.....
2. Mast & Vanes have been painted white & black respectively, replaid
3. The station/pillar was unplaid/not unplaid/constructed on..... 2.6 NOV. 1999, dimensions now being:

Description of mark: Brass Plug, should be explicit, e.g. S/Steel Pillar Plate, Steel plug, Brass plug, Bolt, G.L. Pipe
 Height of mark: 0.04 m. above back/concrete; Mark is..... m. above G.L.

Height of Top Vanes to Top Mark/Pillar plate: NA m. Diameter of Vanes (vertical):..... m.
 Height of Cairn: 1.2 m. Diameter of Cairn: 2.2 m. Name Plate found/not found/placed.
 Length of Mast:..... m. (approximate if not unplaid)

4. A..... set in conc/rock has been placed/found; bearing.....° M from Mast/Plug/Pillar
5. A..... set in conc/rock has been placed/found; bearing.....° M from Mast/Plug/Pillar
6. A..... set in conc/rock has been placed/found; bearing.....° M from Mast/Plug/Pillar
7. A..... set in conc/rock has been placed/found; bearing.....° M from Mast/Plug/Pillar
8. Action required: NEW MAST CARBON NEEDS REPAIRING.

STANDPOINT:

STANDPOINT:


Mark	Direction	Horiz. Distance	Height Difference	Mark	Direction	Horiz. Distance	Height Difference
			above standpt.				above standpt.
			below standpt.				below standpt.
			above standpt.				above standpt.
			below standpt.				below standpt.
Figured by: [Signature] 14/10/99


Checked:

Noted on U.T.M. Card

Checked

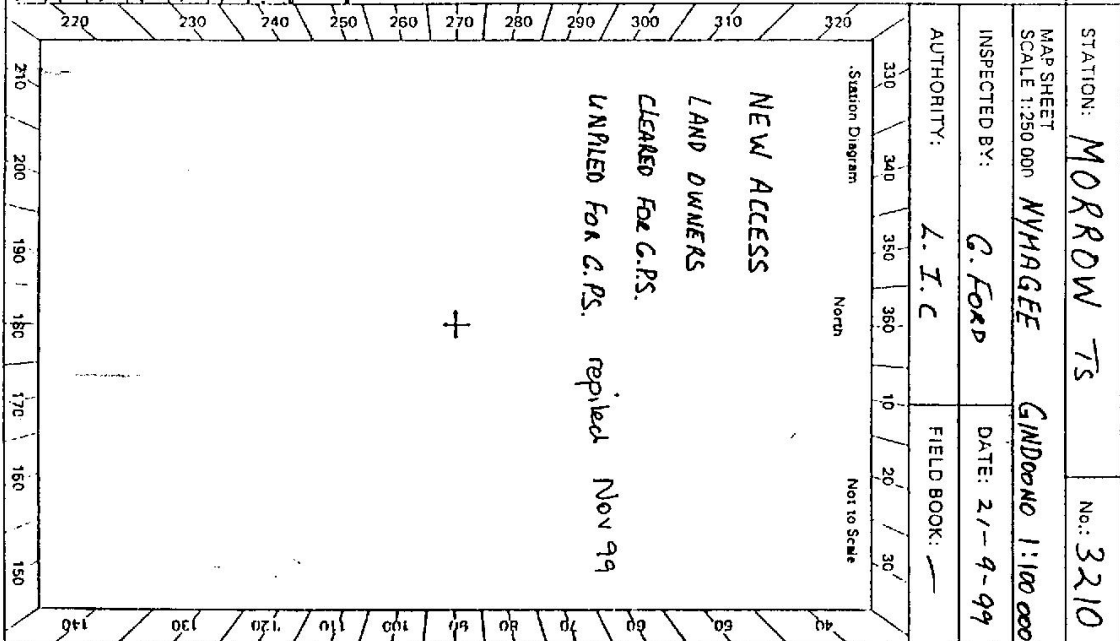

ST 2733-2 D. West. Government Printer

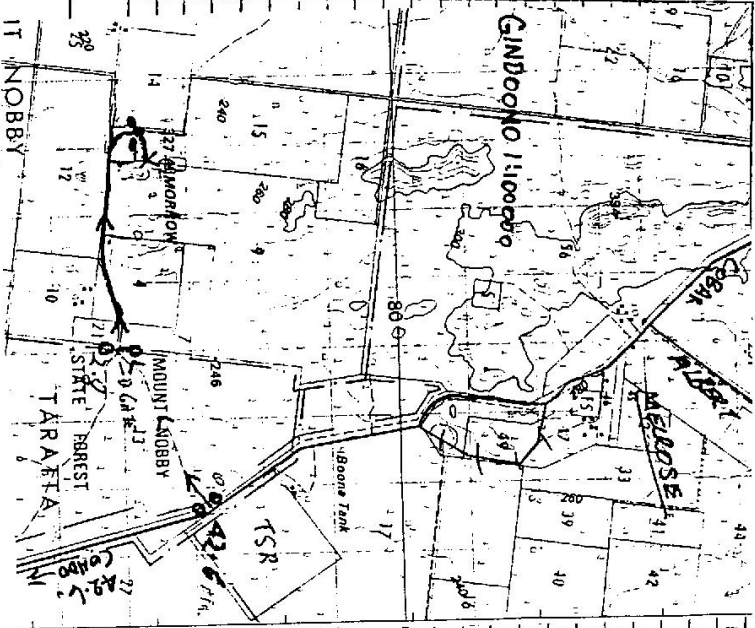

Not to Scale

Original beacon found/not found.
 Description of beacon:
 Height Top of Vanes to Top Mark: m.
 Height of mark: m. above rock/cone m. below G.L.
 Diameter of Vanes m. Height of Cairn m.
 Original Beacon has/has not been destroyed by me.

STATION MORROW TS 3210

*** Owner's Name: BRUCE WATTS & NATHARINE SCHOEFFEL**
 Address: "NYORA" (23 Km. on Road) CONDO - COBAR RD.
 Phone: 6896 2935
 Current Occupant: MRS CASKEY
 Address: CONDO - COBAR RD.
 Phone:

3210 MORROW TS

Access Report of/19..... was found suitable/unsuitable.

- 0.00 7.00 PO Condobolin head towards Cobar for abt 42.6 KM
- 2.80 4.20 Left through gate into Mount Nobly State Forest (opp TSR reserve)
- 3.45 3.55 Double iron gates into Mrs Caskey land
- 3.50 3.50 Road veers left towards house go right to fence corner & gates
- 6.00 1.00 3 small gates
- 6.45 0.55 Tank on right
- 6.60 0.40 Double iron gates (trig owner land)
- 6.80 0.20 Turn right off track to wards hill
- 7.00 0.00 Cross small dry creek
- Stop at small pile of rocks
- Walk up from southern end of hill 10 mins to trig

Travel time 43 KM from condo bitumen RD
 + 30 mins from turn off to trig

WATT BRUCE & SCHOEFFEL KATE Search Again
 VET SURGNS 9 MELROSE ST CONDOBOLIN 2877 (02) 6895-2511
 NYORA CONDOBOLIN 2877 (02) 6896-2935
 MOBILE SERVICE 017 915 640

*** NOTE BRUCE WATT SAID NOT TO CONTACT MRS CASKEY BECAUSE HE WILL CONTACT HER (SHE HAS FENCE OFF ANOTHER ACCESS)**

21/9/99