

GEODETTIC SURVEY OF N.S.W.

CENTRAL MAPPING AUTHORITY

GEODETTIC STATION RECONNAISSANCE and MAINTENANCE REPORT

STATION: *MOUNTAIN ASH G.S.* FS No.: *3222*

MAP SHEET SCALE 1:250 000 *GOULBURN*

INSPECTED BY: *M.L. Macrae* DATE: *28/10/78*

AUTHORITY: *C.M.A.* FIELD BOOK: *1710*

Description: *Note: Cross out word or words which do not apply*


1. Created by *lanes bearing*..... *Note: Cross out word or words which do not apply*..... from *Trig, Mast*.
2. Mast & Vanes have been painted *white & black* respectively.
3. The station/pillar was unpiled/not unpiled/constructed on..... *19*....., dimensions now being: Description of mark..... should be explicit, e.g., S/Steel Pillar Plate, Steel plug, Brass plug, Bolt, G.I. Pipe  
Height of mark.....m. <sup>above</sup> rock/concrete; Mark is.....m. <sup>above</sup> G.L.  
Height of Top Vanes to Top Mark/Pillar plate.....m. Diameter of Vanes (vertical).....m.  
Height of Cairn.....m. Diameter of Cairn.....m. Name Plate found/not found/placed.  
Length of Mast.....m. (approximate if not unpiled)
4. A..... set in conc/rock has been placed/found, bearing.....°M from Mast/Plug/Pillar
5. A..... set in conc/rock has been placed/found, bearing.....°M from Mast/Plug/Pillar
6. A..... set in conc/rock has been placed/found, bearing.....°M from Mast/Plug/Pillar
7. A..... set in conc/rock has been placed/found, bearing.....°M from Mast/Plug/Pillar
8. Action required:.....

STANDPOINT:			
Mark	Direction	Horiz. Distance	Height Difference
			above standpt.
			below standpt.
			above standpt.
			below standpt.
Prepared by: *[Signature]* 16/11/78

Checked: *[Signature]*

St. 2733-1

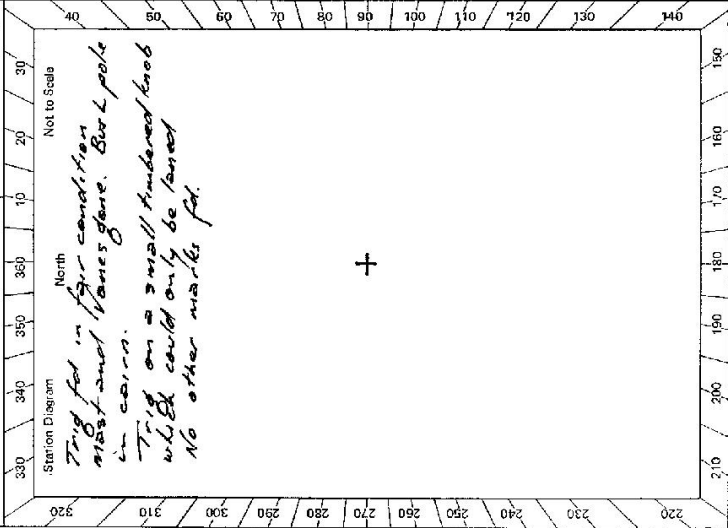

Checked

GS

STATION	MOUNTAIN ASA G.S. TS 3222	
<p>Owner's Name: .....</p> <p>Address: .....</p> <p>Phone: .....</p> <p>Current Occupant: .....</p> <p>Address: .....</p> <p>Phone: .....</p>	<p>ACCESS</p> <p>Access Report of 28/10/1977 was found suitable/unavailable.</p> <p><i>Direction.</i></p> <p><i>Bredobane Hotel, Bredobane. Head along Hwy towards Yass</i></p> <p><i>0.00 Turn right off Hwy Sign Greenwauas H.</i></p> <p><i>1.15 Railway Crossing.</i></p> <p><i>3.70 Turn right Sign Crookwell 29 Greenwauas H.</i></p> <p><i>9.25 Park truck. Trig is on little timbered knob on left</i></p> <p><i>Abt 5 mins walk.</i></p>	<p>Date</p> <p>Record of Station</p>
<p>Beacon Diagram</p>	<p>Not to Scale</p> <p>This section to be completed by officer constructing pillar.</p> <p>Original station mark found/not found.</p> <p>Description of mark: .....</p> <p>Original beacon found/not found.</p> <p>Description of beacon: .....</p> <p>Height Top of Vanes to Top Mark .....m.</p> <p>Height of mark .....m. above G.L. below</p> <p>Diameter of Vanes .....m. Height of Cairn .....m.</p> <p>Original Beacon has/has not been destroyed by me.</p>	