

CENTRAL MAPPING AUTHORITY

GEODETIC SURVEY OF NSW

GEODETIC STATION RECONNAISSANCE and MAINTENANCE REPORT


STATION: **MOWABLA G.S.** No.: **3228**

MAP SHEET SCALE 1:250 000 **NARROMINE**

INSPECTED BY: **A. COOK** DATE: **1978**

AUTHORITY: **C.M.A.** FIELD BOOK:

Description:
 1. Cleared by lanes bearing.....
 Note: *Cross out word or words which do not apply*
 2. Mast & Vanes have been painted white & black respectively.
 3. The station/pillar ~~was~~ *is* not unpiled/constructed on.....19....., dimensions now being:
 Description of mark.....*R.P.D.*.....should be explicit, e.g., S/Steel Pillar Plate, Steel plug, Brass plug, Bolt, G.I. Pipe
 Height of mark.....m.....^{above} rock/concrete; Mark is.....m.....^{above} G.L.
 Height of Top Vanes to Top Mark/Pillar plate.....m..... Diameter of Vanes (vertical).....m.....
 Height of Cairn.....m..... Diameter of Cairn.....m..... Name Plate found/not found/placed.
 Length of Mast.....m..... (approximate if not unpiled)
 4. A.....set in conc/rock has been placed/found, bearing.....° M from Mast/Plug/Pillar
 5. A.....set in conc/rock has been placed/found, bearing.....° M from Mast/Plug/Pillar
 6. A.....set in conc/rock has been placed/found, bearing.....° M from Mast/Plug/Pillar
 7. A.....set in conc/rock has been placed/found, bearing.....° M from Mast/Plug/Pillar
 8. Action required: *NO MAST and base. Little clearing needed. Suitable for pillar.*

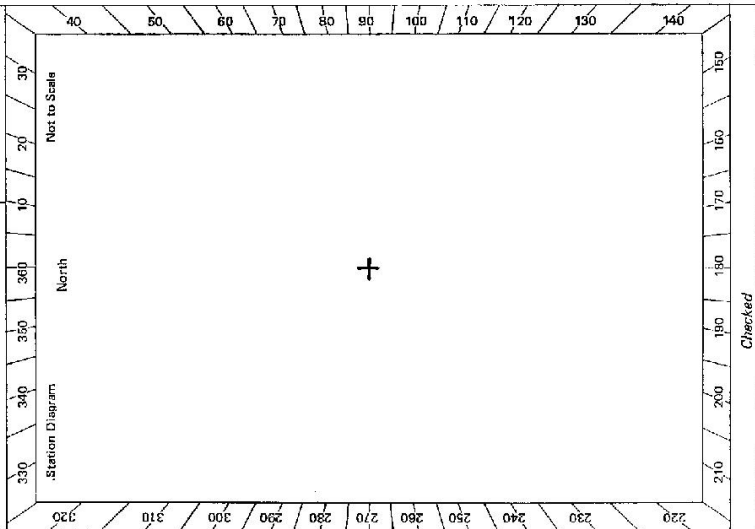

| STANDPOINT: | | | |
|-------------|-----------|-----------------|-------------------|
| Mark | Direction | Horiz. Distance | Height Difference |
| | | | above standpt. |
| | | | below |
| | | | above standpt. |
| | | | below |
Prepared by: **A. COOK** Checked: **U.T.M. Card**

