

CENTRAL MAPPING AUTHORITY
Department of Lands

Trig Station of N.S.W.

RECONNAISSANCE and MAINTENANCE REPORT

This Trig. Station has been:-

Note: Cross out word or words which do not apply

1. Completely cleared to permit 360° vision to surrounding Trigs.
2. Cleared by lanes bearing from Trig. Mast
3. Trig. Mast & Vanes have been painted white & black respectively.
4. The Trig. was ~~unpiled~~ ^{no cairn} unpiled, dimensions now being:

Description of mark STAR, IRON PICKET should be explicit, e.g. Steel plug, Brass plug, Bolt, G.I. Pipe

Height of mark 0.03 m above below rock/concrete G.L.

Height of Top Vanes to Top Mark 0.03 m Diameter of Vanes (vertical) 0.03 m

Height of Cairn 0.03 m Diameter of Cairn 0.03 m

Length of Mast 0.03 m (approximate if not unpiled)

5. A set in conc/rock has been placed 0.03 m bearing 0.03 m from Trig. Mast
6. A set in conc/soil has been placed 0.03 m bearing 0.03 m from Trig. Mast
7. A set in conc/soil has been placed 0.03 m bearing 0.03 m from Trig. Mast
8. A set in conc/rock has been placed 0.03 m bearing 0.03 m from Trig. Mast

9. Connection to 0.03 m bearing 0.03 m

10. Connection to 0.03 m bearing 0.03 m

11. Connection to 0.03 m bearing 0.03 m

12. Connection to 0.03 m bearing 0.03 m

13. Diff. Ht. is 0.03 m above below

14. Diff. Ht. is 0.03 m above below

15. Diff. Ht. is 0.03 m above below

16. Diff. Ht. is 0.03 m above below

Prepared by: P. CARR Checked: Noted on U.T.M. Card

STATION MT. LAXTER TS 3231

Co: NORTHUMBERLAND Ph: ST. ALBANS

Map Sheet: GOSFORD No: 9131 S

Inspected by: P. CARR Date: 7/8/76

Authority: Field Book:

Beacon Diagram: Not to Scale



Star iron picket in soil Rd. surrounded by a few small rocks.

Record of Station

Date

Non-Geodetic

Address

Address.....

Possible with 2 wheel drive if taken slow:

SMALL BRIDGE

TURN RIGHT ON TRACK UP HILL. SIGN "OLD GREAT NORTHERN ROAD"

FOLLOW TRACK TO RIGHT.

FOLLOW MAIN TRACK. SERVICE TRAIL ON RIGHT.

FOLLOW TRACK TO RIGHT.

TURN LEFT AT FORK.

FOLLOW TRACK ONWARDS.

DIRT PILE ON RIGHT.

FOLLOW TRACK TO LEFT:

FOLLOW TRACK ONWARDS.

FOLLOW TRACK ONWARDS.

FOLLOW TRACK ONWARDS

HOUSE ON LEFT.

TURN LEFT AT FORK.


WOODEN BRIDGE.

WOODEN BRIDGE.

INTERSECTION. SIGN "PHAROS NATIONAL PARK" - TAKE TRACK SHARP LEFT.

FOLLOW TRACK ONWARDS.

MT. BAXTER ON LEFT. 5 min climb to T.S.

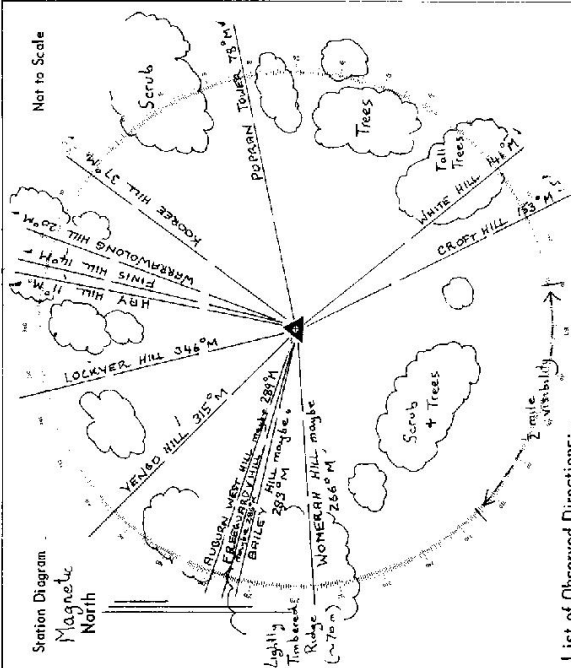

List of Observed Directions:—

Standpoint:

[illegible]