

**LAND INFORMATION CENTRE**

GEODETIC SURVEY OF N.S.W.

**GEODETIC STATION RECONNAISSANCE and MAINTENANCE REPORT**

Description:

1. Cleared by lanes bearing..... *NOT CLEAR* ..... from Trig. Mast  
 Note: Cross out word or words which do not apply

2. Mast & Vanes have been painted white & black respectively.

3. The station/pillar was unpiled/not unpiled/constructed on ..... 19....., dimensions now being:

Description of mark *BRASS PLAQUE* ..... should be explicit, e.g., S/Steel Pillar Plate, Steel plug, Brass plug, Bolt, G.I. Pipe

Height of mark.....m. <sup>above</sup> rock/concrete; Mark is.....m. <sup>above</sup> G.L. <sub>below</sub>

Height of Top Vanes to Top Mark/Pillar plate .....m. Diameter of Vanes (vertical).....m.

Height of Cairn.....m. Diameter of Cairn.....m. Name Plate found/not found/placed.

Length of Mast .....m. (approximate if not unpiled)

4. A.....set in conc./rock has been placed/found, bearing.....° M from Mast/Plug/Pillar

5. A.....set in conc./rock has been placed/found, bearing.....° M from Mast/Plug/Pillar

6. A.....set in conc./rock has been placed/found, bearing.....° M from Mast/Plug/Pillar

7. A.....set in conc./rock has been placed/found, bearing.....° M from Mast/Plug/Pillar

8. Action required:.....


STANDPOINT:

STANDPOINT:

Mark	Direction	Horiz. Distance	Height Difference	Mark	Direction	Horiz. Distance	Height Difference
			above standpt.				above standpt.
			below				below
			above standpt.				above standpt.
			below				below
Prepared by: *G Ford* 13/1/90

Checked: *[Signature]* Noted on U.T.M. Card

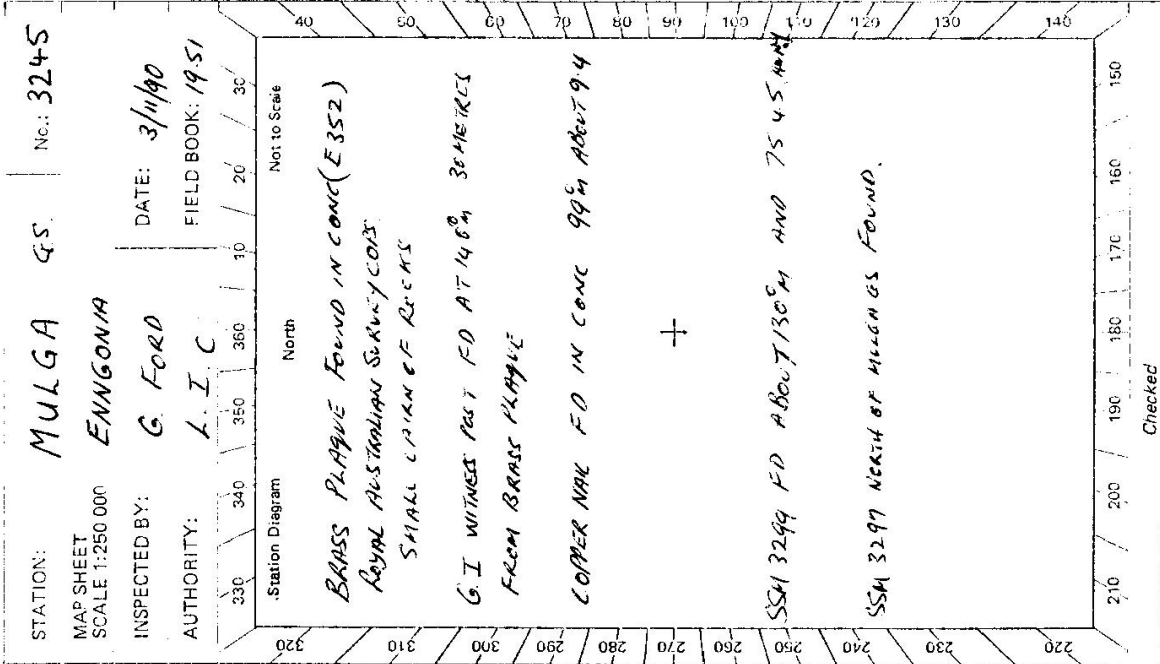

STATION: **MULGA GS** No.: **3245**

MAP SHEET **ENNGONIA**

INSPECTED BY: **G FORD** DATE: **3/1/90**

AUTHORITY: **L. I. C.** FIELD BOOK: **1951**

