

CENTRAL MAPPING AUTHORITY
 GEODETIC SURVEY OF N.S.W.
 GEODETIC STATION RECONNAISSANCE and MAINTENANCE REPORT

- Description: _____
- Note: Cross out word or words which do not apply
1. Cleared by lanes bearing: _____ from Trig. Mast
 2. Mast & Vanes have been painted white & black respectively.
 3. The station/~~pillar~~ was ~~erected~~/not unplied/~~erected~~ on 20/10/1978, dimensions now being: _____
- Description of mark: _____ should be explicit, e.g., S/Steel Pillar Plate, Steel plug, Brass plug, Bolt, G.I. Pipe
- Height of mark: _____ m. ^{above} rock/concrete; _____ m. ^{below} G.L.
- Height of Top Vanes to Top Mark/Pillar plate: _____ m. Diameter of Vanes (vertical): 0.94 m.
- Height of Cairn: 1.50 m. Diameter of Cairn: 2.00 m. Name Plate ~~found~~/not found/~~placed~~.
- Length of Mast: 3.79 m. (approximate if not unplied)
4. A. _____ set in conc./rock has been placed/found, bearing: _____ ° M from Mast/Plug/Pillar
 5. A. _____ set in conc./rock has been placed/found, bearing: _____ ° M from Mast/Plug/Pillar
 6. A. _____ set in conc./rock has been placed/found, bearing: _____ ° M from Mast/Plug/Pillar
 7. A. _____ set in conc./rock has been placed/found, bearing: _____ ° M from Mast/Plug/Pillar
 8. Action required: _____

Report

*Trig. still in good condition, no other marks for
 Hill could only be used, to be cleared per lane depending
 on direction of clearing (NS, S, W, direction of forest lanes)*

Prepared by: [Signature] 14/10/78
 Checked on U.T.M. Card

STATION: Mullenskulunga G.S. No. 3254
 MAP SHEET SCALE 1:250 000
 INSPECTED BY: M.L. Morrison DATE: 20/10/78
 AUTHORITY: C.M.A. FIELD BOOK: 1710

Station Diagram

Not to Scale


Station **MULLENGULLENGA G.S. IS 3254**

Owner's Name: **J.F. BENEVIDA**
 Address: **FERNETEM**
MINDILLAWA
 Phone: **45 5138**

Current Occupant:
 Address:
 Phone:

ACCESS
 Access Report of 10/10/1978 was found suitable/unsuitable.
 Direction
0.00 MULLENGULA PUBLIC SCHOOL. HEAD TOWARDS GOVERNOR
0.80 TURN LEFT INTO MIDDLE GATE TO 'BELMEDI'
1.50 1.75 + 2.50 GATES
2.65 TURN LEFT ONTO TRACK JUST AFTER CREEK CROSSING
FOLLOW UP PAST HOUSE. (R.H. TRACK TO BELMEDI 'W BENEVIDA'S')

3.10 GATE
3.95 THROUGH GATE FOLLOW TRACK STRAIGHT AHEAD
4.85 GATE
5.00 FOLLOW TRACK KEEPING SHEAR ON LEFT.
5.90 FOLLOW TRACK ON R.H.S OF FENCE
6.20 THROUGH GATEWAY JUST AFTER CREEK CROSSING
PASSING OLD SHACK ON RIGHT
GATE
6.65 TURN RIGHT ONTO FAINT TRACK BEHIND DAM.
6.80 TURN LEFT OFF TRACK MAKE OWN WAY UP RIDGE
6.90 MULLENGULLENGA G.S.
7.90

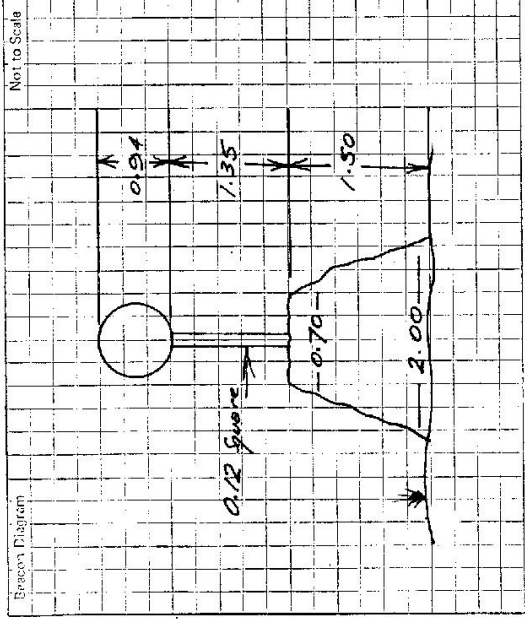

This section to be completed by officer constructing pillar.
 Original station mark found/not found.
 Description of mark:
 Original beacon found/not found.
 Description of beacon:
 Height T. of Vanes to Top Markm.
 Height of markm. above G.L.
 below rock/cont.
 Diameter of Vanesm. Height of Cairnm.
 Original Beacon has/has not been destroyed by me.

Date	Record of Station

GEODETTIC SURVEY OF N.S.W.

CENTRAL MAPPING AUTHORITY


GEODETTIC STATION RECONNAISSANCE and MAINTENANCE REPORT

STATION: *MULLENGULLENGGA* No.: *3254*

MAP SHEET
SCALE 1:250 000
Canberra

INSPECTED BY: *Pk. Bamela* DATE: *Approx. May 19*

AUTHORITY: *C.M.A* FIELD BOOK:

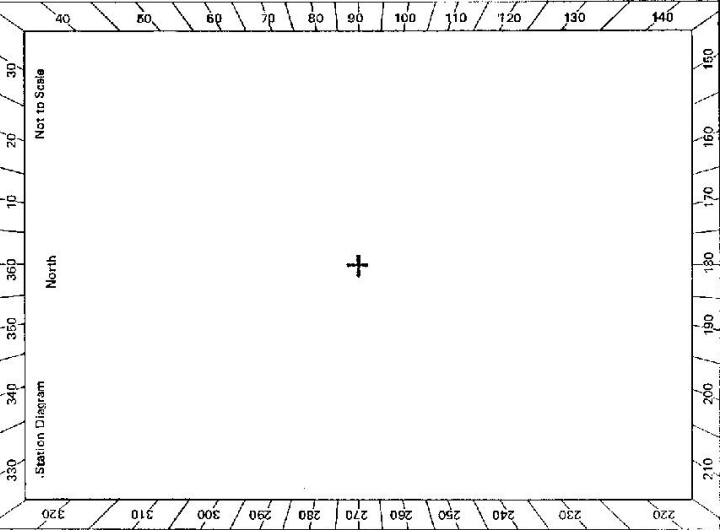

- Description:
1. Cleared by lanes bearing.....
Note: Cross out word or words which do not apply
2. Mast & Vanes have been **printed white & black respectively, found in pairs of rocks**.
3. The station/~~pillar~~ was ~~unplaced~~/~~constructed on~~.....~~ft~~.....~~ft~~....., dimensions now being:
- Description of mark.....should be explicit, e.g., S/Steel Pillar Plate, Steel plug, Brass plug, Bolt, G.I. Pipe
- Height of mark.....m. ^{above} rock/concrete; Mark is.....m. ^{above} G.L.
- Height of Top Vanes to Top Mark/Pillar platem. Diameter of Vanes (vertical).....m.
- Height of Cairn.....m. Diameter of Cairn.....m. Name Plate found/not found/placed.
- Length of Mast.....m. (approximate if not unplaced)
4. A.....set in conc./rock has been placed/found, bearing.....° M from Mast/Plug/Pillar
5. A.....set in conc./rock has been placed/found, bearing.....° M from Mast/Plug/Pillar
6. A.....set in conc./rock has been placed/found, bearing.....° M from Mast/Plug/Pillar
7. A.....set in conc./rock has been placed/found, bearing.....° M from Mast/Plug/Pillar
8. Action required: *Station needs paint. Station is surrounded by heavy timber cover - Approx to 4 days clearing*

STANDPOINT:

Mark	Direction	Horiz. Distance	Height Difference	Mark	Direction	Horiz. Distance	Height Difference
			above standpt.				above standpt.
			below				below
			above standpt.				above standpt.
			below				below
Prepared by: *Pk Bamela* 21/5/22

Checked:

Checked

Noted on U.T.M. Card

