

TS 3255


No.: 249c

STATION: Mullins

MAP SHEET SCALE 1:250 000 CANBERRA

INSPECTED BY: P.K. Bamola DATE: May 1979

AUTHORITY: CMA FIELD BOOK:

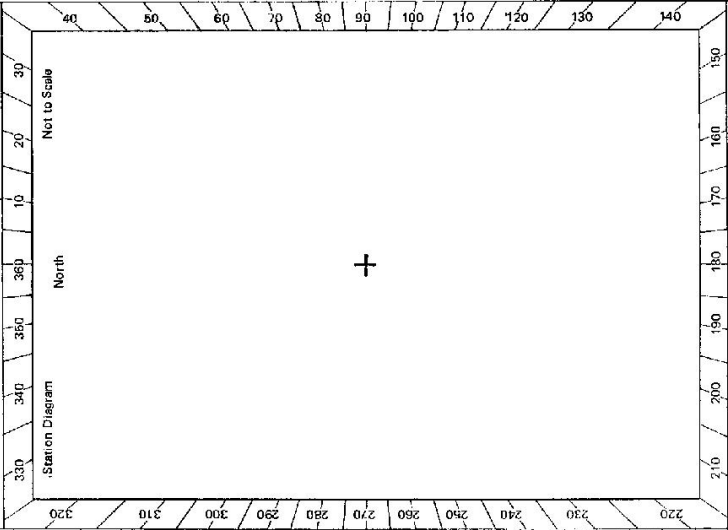

GEODETTIC STATION RECONNAISSANCE and MAINTENANCE REPORT

Description: Note: Cross out word or words which do not apply

1. Cleared by lanes bearing..... from Trig, Mast
2. Mast & Vanes have been painted white & black respectively.
3. The station/pillar was ~~erected~~ ^{found} ~~constructed on~~ ⁱⁿ ~~rocks~~ ^{in Cairn of rocks} ~~found~~ ^{found} ~~to~~ ^{to} ~~dimensions now being~~ ^{found}.
Description of mark..... should be explicit, e.g., S/Steel Pillar Plate, Steel plug, Brass plug, Bolt, G.I. Pipe
- Height of mark.....m. ^{above} rock/concrete; Mark is.....m. ^{above} G.L.
- Height of Top Vanes to Top Mark/Pillar plate.....m. Diameter of Vanes (vertical).....m.
- Height of Cairn.....m. Diameter of Cairn.....m. Name Plate found/not found/placed.
- Length of Mast.....m. (approximate if not unplied)
4. A.....set in conc/rock has been placed/found, bearing.....° M from Mast/Plug/Pillar
5. A.....set in conc/rock has been placed/found, bearing.....° M from Mast/Plug/Pillar
6. A.....set in conc/rock has been placed/found, bearing.....° M from Mast/Plug/Pillar
7. A.....set in conc/rock has been placed/found, bearing.....° M from Mast/Plug/Pillar

8. Action required: Station: close to Site: suitable for pillar Estimate
5 days clearing required

STANDPOINT:			
Mark	Direction	Horiz. Distance	Height Difference
			above standpt.
			below standpt.
			above standpt.
			below standpt.
Prepared by: P.K. Bamola 14/6/79 Checked: Noted on U.T.M. Card

ST 27733-2 D. West, Government Printer Beacon Diagram	<table border="1" style="width: 100%; border-collapse: collapse; height: 150px;"> <tr> <th style="width: 5%;">Not to Scale</th> <th style="width: 5%;"> </th> <th style="width: 5%;"> </th> <th style="width: 5%;"> </th> <th style="width: 5%;"> </th> <th style="width: 5%;"> </th> <th style="width: 5%;"> </th> <th style="width: 5%;"> </th> <th style="width: 5%;"> </th> <th style="width: 5%;"> </th> <th style="width: 5%;"> </th> <th style="width: 5%;"> </th> <th style="width: 5%;"> </th> <th style="width: 5%;"> </th> </tr> <tr> <td> </td><td> </td><td> </td><td> </td><td> </td><td> </td><td> </td><td> </td><td> </td><td> </td><td> </td><td> </td><td> </td><td> </td></tr> <tr> <td> </td><td> </td><td> </td><td> </td><td> </td><td> </td><td> </td><td> </td><td> </td><td> <tr> <td> </td><td> </td><td> </td><td> </td><td> </td><td> </td><td> </td><td> </td><td> </td><td> </td><td> </td><td> </td><td> </td><td> </td></tr> <tr> <td> </td><td> </td><td> </td><td> </td><td> </td><td> </td><td> </td><td> </td><td> </td><td> </td><td> </td><td> </td><td> </td><td> </td></tr> <tr> <td> </td><td> </td><td> </td><td> </td><td> </td><td> </td><td> </td><td> </td><td> </td><td> </td><td> </td><td> </td><td> </td><td> </td></tr> </table>	Not to Scale																																																																																																																																																										STATION <i>Mullins</i> TS <i>3255</i> Owner's Name: Address: Phone: Current Occupant: Address: Phone: Access Report of/19 was found suitable/unsuitable. <i>Station Drive-to</i> <i>Refer Base 1:35000 sheet</i>
Not to Scale																																																																																																																																																												
This section to be completed by officer constructing pillar. Original station mark found/not found. Description of mark: Original beacon found/not found. Description of beacon: Height Top of Vanes to Top Mark m. Height of mark m. above G.L. below rock/conc m. Diameter of Vanes m. Height of Cairn m. Original Beacon has/has not been destroyed by me.		Date Record of Station																																																																																																																																																										