

GEODETTIC SURVEY OF N.S.W.

CENTRAL MAPPING AUTHORITY

GEODETTIC STATION RECONNAISSANCE and MAINTENANCE REPORT

STATION: *MULWAREE G.S.* No.: *3257*

MAP SHEET: *CANBERRA*

INSPECTED BY: *M.L. Macerison* DATE: *18/10/18*

AUTHORITY: *C.M.A.* FIELD BOOK: *1710*

Description: *105.2, 110.2* Note: Cross out word or words which do not apply

1. ~~Cleared by fence bearing~~ *230.2, 295.2, 320.2, 322.2, 327.2* from Trig. Mast

2. ~~Mast & Vanes have been painted white & black respectively.~~

3. The station/~~pillar~~ ~~was~~ ~~unfilled~~/~~not~~ ~~unfilled~~/~~constructed~~ on *18/10/1978* dimensions now being:

Description of mark.....should be explicit, e.g., S/Steel Pillar Plate, Steel plug, Brass plug, Bolt, G.I. Pipe

Height of mark.....m. ^{above} rock/concrete; ~~Mark is~~.....m. ^{above} G.L.

Height of Top Vanes to Top Mark/Pillar plate.....m. Diameter of Vanes (vertical).....m.

Height of Cairn.....m. Diameter of Cairn.....m. Name Plate found/not found/placed.

Length of Mast.....m. (approximate if not unplied)

4. A. ~~S.S.M.~~.....set in conc/~~rock~~ has been ~~placed~~/found, bearing.....° M from Mast/~~Height~~/~~Pillar~~

5. A.....set in conc/rock has been placed/found, bearing.....° M from Mast/Plug/Pillar

6. A.....set in conc/rock has been placed/found, bearing.....° M from Mast/Plug/Pillar


7. A.....set in conc/rock has been placed/found, bearing.....° M from Mast/Plug/Pillar

8. Action required:.....


STANDPOINT:			
Mark	Direction	Horiz. Distance	Height Difference
			above standpt.
			below standpt.
			above standpt.
			below standpt.
Prepared by: *[Signature]* 18/11/18 Checked: *[Signature]* Noted on U.T.M. Card

SA 2738-1

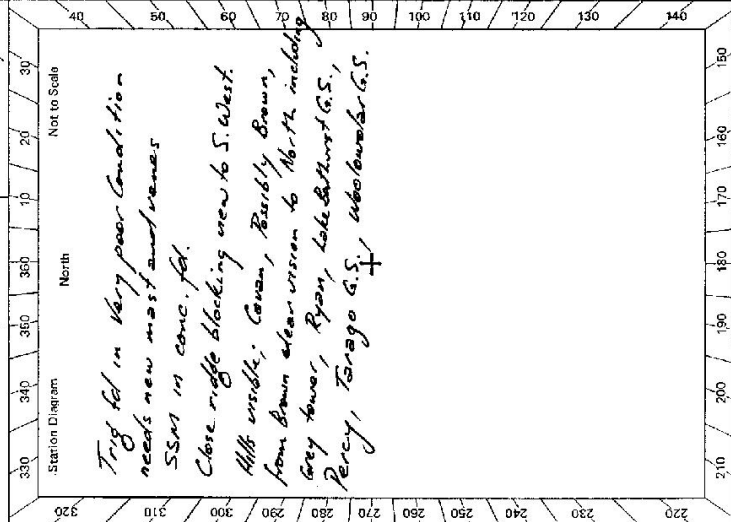

6

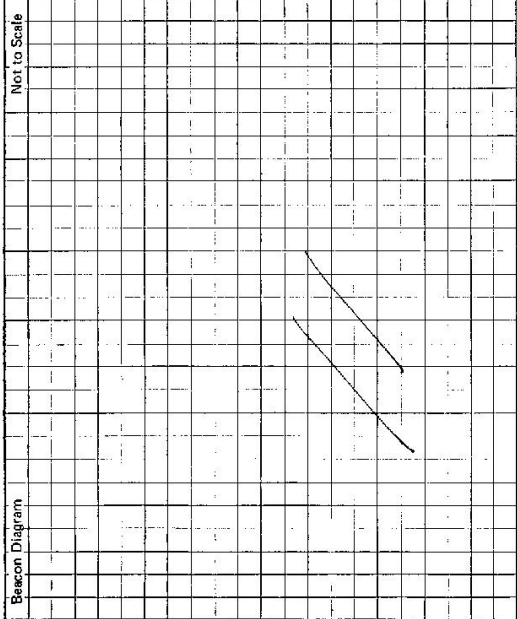STATION MULWAREE G.S. TS 3257	Owner's Name: BOYGALAI / LAKE BATHURST Address: LAKE BATHURST Phone: Current Occupant: Address: Phone:	ACCESS Access Report of 18/10/1978 was found suitable/unsuitable.	Not to Scale 	This section to be completed by officer constructing pillar. Original station mark found/not found. Description of mark: Original beacon found/not found. Description of beacon: Height Top of Vanes to Top Mark:m. Height of mark:m. above G.L. below Diameter of Vanes:m. Height of Cairnm. Original Beacon has/has not been destroyed by me.
Date		Record of Station		

Kn
 0.00 Lake Bathurst Public School head towards Goulburn
 1.35 Turn left off main road, cross railway line and
 turn left through iron gate into paddock and
 make way up to top of ridge
 1.85 MULWAREE G.S.

CENTRAL MAPPING AUTHORITY

GEODETIC SURVEY OF M.S.W.

GEODETIC STATION RECONNAISSANCE and MAINTENANCE REPORT

Description:

Note: Cross out word or words which do not apply

1. Cleared-by-lanes-bearing: ^{350°}..... from Trig. Mast
2. Mast & Vanes have been painted white & black respectively. *in pairs of rocks found*
3. The station/pillar was unpiled/not unpiled/constructed on.....19....., dimensions now being: Description of mark.....should be explicit, e.g., S/Steel Pillar Plate, Steel plug, Brass plug, Bolt, G.I. Pipe
- Height of mark.....m. ^{above} rock/concrete; Mark is.....m. ^{below} G.L.
- Height of Top Vanes to Top Mark/Pillar platem. Diameter of Vanes (vertical).....m.
- Height of Cairn.....m. Diameter of Cairn.....m. Name Plate found/not found/placed.
- Length of Mastm. (approximate if not unpiled)
4. A.....set in conc/rock has been placed/found, bearing.....° M. from Mast/Plug/Pillar
5. A.....set in conc/rock has been placed/found, bearing.....° M. from Mast/Plug/Pillar
6. A.....set in conc/rock has been placed/found, bearing.....° M. from Mast/Plug/Pillar
7. A.....set in conc/rock has been placed/found, bearing.....° M. from Mast/Plug/Pillar
8. Action required: *Base on stands to be replaced*

STANDPOINT:

STANDPOINT:

Mark	Direction	Horiz. Distance	Height Difference	Mark	Direction	Horiz. Distance	Height Difference
			above standpt.				above standpt.
			below				below
			above standpt.				above standpt.
			below				below
Prepared by: *P. K. Ramela 14/3/19* Checked: *U.T.M. Curd*

St 2733-1

STATION: *Mulwara* No.: *3257*

MAP SHEET SCALE 1:250 000 *Conbarua*

INSPECTED BY: *P. K. Ramela* DATE: *21/4/19*

AUTHORITY: *C.M.A* FIELD BOOK:

Station Diagram

Not to Scale

CENTRAL MAPPING AUTHORITY

GEODETTIC SURVEY OF N.S.W.

GEODETTIC STATION RECONNAISSANCE and MAINTENANCE REPORT

Description:

- Note: Cross out word or words which do not apply
- Cleared by lanes bearing Iron Block vision from plus off at from Trig. Mast 10.5 M 110 M, 2.30 M, 2.95 M, 3.05 M, 3.27 M, 3.33 M.
 - Mast & Vanes have been painted white & black respectively. X Remains only of Mast & Vanes on Ground.
 - The station/pillar was unplaced/concreted on 3.7 19.84, dimensions now being: Found unplaced concreted.
- Description of mark BRONZE PIN should be explicit, e.g., S/Steel Pillar Plate, Steel plug, Brass plug, Bolt, G.I. Pipe
- Height of mark 0.32 m. above rock/concrete; Mark is 3 m. above G.L.
- Height of Top Vanes to Top Mark/Pillar plate m. Diameter of Vanes (vertical).....m.
- Height of Cairn.....m. Diameter of Cairn.....m. Name Plate found/not found/placed.
- Length of Mast.....m. (approximate if not unplaced)
- A.....5.5M.....set in conc/rock has been placed/found, bearing 132 °M from Mast/Plug/Pillar
 - A.....set in conc/rock has been placed/found, bearing..... °M from Block/Plug/Pillar
 - A.....set in conc/rock has been placed/found, bearing..... °M from Mast/Plug/Pillar
 - A.....set in conc/rock has been placed/found, bearing..... °M from Mast/Plug/Pillar
- Action required:.....

STANDPOINT:

Mark	Direction	Horiz. Distance	Height Difference	Mark	Direction	Horiz. Distance	Height Difference
			above standpt				below
			below				above standpt
			above standpt				below
			below				above standpt
Prepared by: D. J. KAIN

Checked: PH

Noted on U.T.M. Card

STATION: MULLWINGEE Geodetic Station No.: 3257

MAP SHEETS SCALE 1:250 000 CANBERRA. SCALE 1:100 000 BRANDWOOD.

INSPECTED BY: D. J. KAIN. DATE: 3.7.1984.

AUTHORITY: C. M.A. FIELD BOOK: 1952.

Station Diagram

North

Not to Scale

Hills visible are, COVAN, GRAY FOWLER, RYAN, TARAGO, LAKE BATHURST G.S., PERLY, TARAGO, MR Woodrowlake G.S. S.S.M.

MULLWINGEE.
(BRONZE PIN.)

Close Ridge Blocks Vision To the South West.

Very Good Trig Site Commanding Good Views in most directions.

Checked PH

