

GEODETTIC SURVEY OF N.S.W.

CENTRAL MAPPING AUTHORITY

GEODETTIC STATION RECONNAISSANCE and MAINTENANCE REPORT


Description:

1. Cleared by lances bearing 360° *Note: Cross out word or words which do not apply*
edge raise at 0-230 from Trig. Mast
2. Mast & Vanes have been painted white & black respectively. ✓
3. The station/~~pillar~~ was ~~unplaced~~/not unplaced/~~constructed~~ on $12-2$ *19.81*, dimensions now being:
 Description of mark *brass plug* should be explicit, e.g., S/Steel Pillar Plate, Steel plug, Brass plug, Bolt, G.I. Pipe
 Height of mark 0.047 m. ^{above rock/concrete} Mark is 1.600 m. ^{above} ~~below~~ G.L. *Approx.*
 Height of Top Vanes to Top Mark/~~Plate~~ *3.515* m. Diameter of Vanes (vertical) 0.915 m.
 Height of Cairn 1.900 m. Diameter of Cairn 2.100 m. *Approx.* Name Plate ~~found~~/not ~~found~~/placed.
 Length of Mastm. (approximate if not unplaced)
4. A. *Bolt* set in ~~conc~~/rock has been placed/~~found~~, bearing 284° M from Mast/Plug/Pillar
5. A. set in conc/rock has been placed/ found, bearing M from Mast/Plug/Pillar
6. A. set in conc/rock has been placed/ found, bearing M from Mast/Plug/Pillar
7. A. set in conc/rock has been placed/ found, bearing M from Mast/Plug/Pillar
8. Action required: *CONSTRUCTION CONCRETE PILE* *STANDPOINT: Bolt in Rock*

Mark	Direction	Horiz. Distance	Height Difference	Mark	Direction	Horiz. Distance	Height Difference
NELLESLEY GCP	0 00 00	✓	above standpt	NELLESLEY GCP	0 00 00	✓	above standpt
NELLESLEY GCP	31 58 10	✓	above standpt	NELLESLEY GCP	31 58 30	✓	above standpt
NELLESLEY GCP	296 28 00	✓	above standpt	BRASS TRIG PUG	162 41 10 4.502	✓	above standpt
BOLT IN ROCK	342 41 10 4.540	✓	above standpt	CANTONBAI GCP	296 25 00	✓	above standpt
			below standpt				below standpt
			above standpt				above standpt
			below standpt				below standpt
			above standpt				above standpt
			below standpt				below standpt

Prepared by: *PHRS 272 P.* Checked: *Michael Clark 3-4-81* Noted on U.T.M. Card

Checked

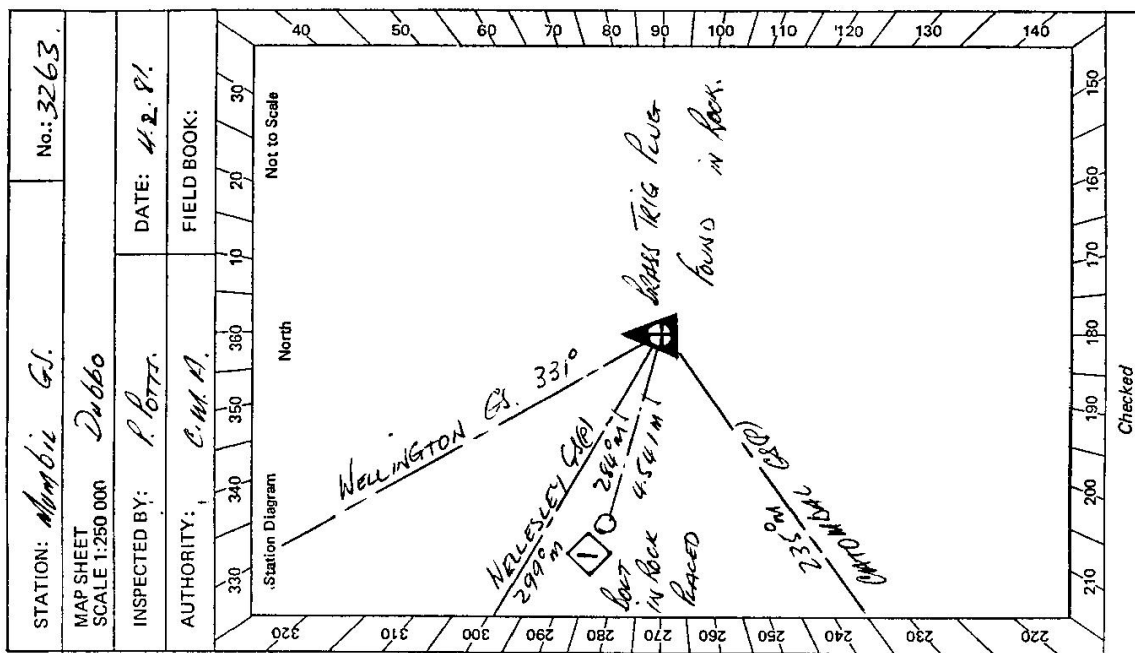

STATION: *Mumbie G.I.* No.: *3263*
 MAP SHEET SCALE 1:250 000 *Dubbo*
 INSPECTED BY: *P. POTTE* DATE: *4.2.81*
 AUTHORITY: *C.M.A.* FIELD BOOK:

ST 2733-1

