

CENTRAL MAPPING AUTHORITY

GEODETIC SURVEY OF N.S.W.

GEODETIC STATION RECONNAISSANCE and MAINTENANCE REPORT

- Description:
1. Cleared by lanes bearing.....
 Note: *Cross out word or words which do not apply*
 2. Mast & Vanes have been painted white & black respectively.
 from Trig. Mast
 3. The station/pillar ~~was not~~ not unpiled/constructed on.....19....., dimensions now being:
 Description of mark.....^{above} S/Steel Pillar Plate, Steel plug, Brass plug, Bolt, G.I. Pipe
 Height of mark.....m.....^{above} rock/concrete; Mark is.....m.....^{above} G.L.
 Height of Top Vanes to Top Mark/Pillar platem. Diameter of Vanes (vertical).....^{2.5}.....m.
 Height of Cairn.....^{2.0}.....m. Diameter of Cairn.....^{2.0}.....m. Name Plate found/not found/placed.
 Length of Mast.....^{4.0}.....m. (approximate if not unpiled)
 4. A.....set in conc/rock has been placed/found, bearing.....° M from Mast/Plug/Pillar
 5. A.....set in conc/rock has been placed/found, bearing.....° M from Mast/Plug/Pillar
 6. A.....set in conc/rock has been placed/found, bearing.....° M from Mast/Plug/Pillar
 7. A.....set in conc/rock has been placed/found, bearing.....° M from Mast/Plug/Pillar
 8. Action required: *1 Day clearing needed. Suitable for Pillar. Good condition.*

STANDPOINT:

Mark	Direction	Horiz. Distance	Height Difference	Mark	Direction	Horiz. Distance	Height Difference
			above standpt.				above standpt.
			below				below
			above standpt.				above standpt.
			below				below
Prepared by: **R. COOK**

Checked: **Noted on U.T.M. Card**

61 2733-1

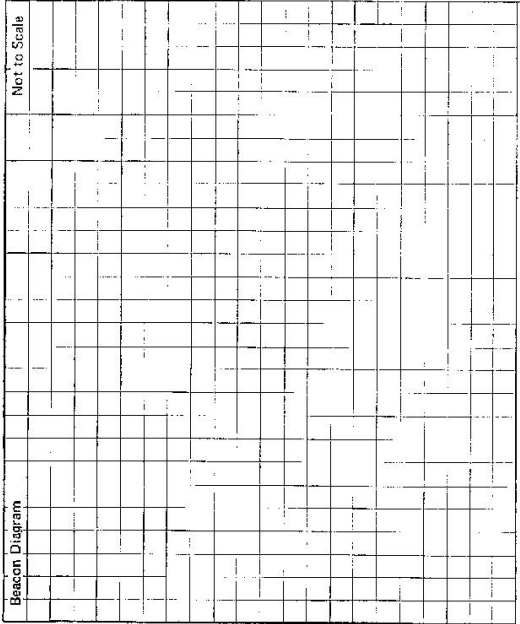
STATION: **MURRUMBIDGE G.S.** No: **3289**
 MAP SHEET SCALE 1:250 000 **NARROMINE**
 INSPECTED BY: **R. COOK** DATE: **SEP 1978**
 AUTHORITY: **C.M.A.** FIELD BOOK:

Station Diagram

North

Map to Scale

St. 2738-2 D. West, Government Printer

<p>STATION MURRUMBIDGE G.S. TS 3289</p>	<p>Owner's Name: Current Occupant: Address: Phone: Phone:</p> <p style="text-align: center;"><u>ACCESS</u></p> <p>Access Report of Sept 1978 / 19..... was found suitable/unsuitable. If a small amount of clearing is done. It is possible to Drive to the trig. Access found on the Field 1:50,000 Sheet.</p>
<p>Beacon Diagram</p>	<p>Net to Scale</p> 
<p>This section to be completed by officer constructing pillar. Original station mark found/not found. Description of mark: Original beacon found/not found. Description of beacon: Height Top of Vane to Top Markm. Height of markm. above G.L. below rock/conc.m. below Diameter of Vanem. Height of Cairnm. Original Beacon has/has not been destroyed by me.</p>	
<p>Date</p>	<p>Report of Station</p> <p>SEPT. 1978 STATION VISITED IN CONNECTION WITH FIELD COMPLETION.</p>